


TOWN OF LEXINGTON — BOARD OF PUBLIC WORKS

SEWER DIVISION

DATE _____

Sketch of Service Here

15

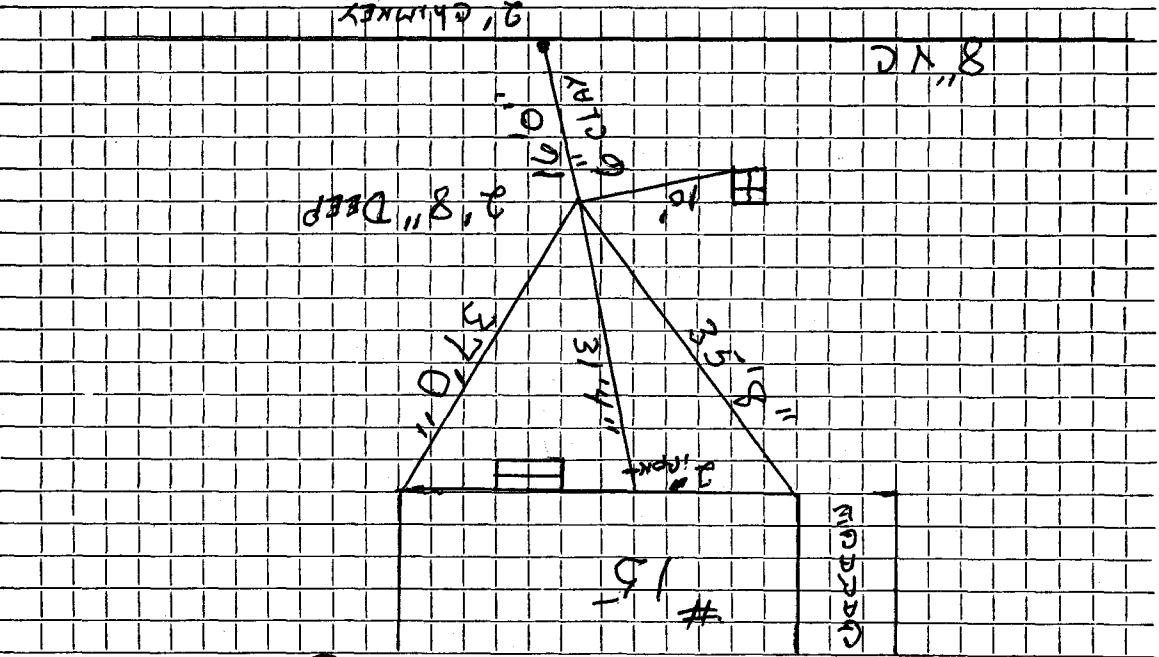

NOTE
2-0 CHIM

Work completed

Street

Connection made in

Remarks: