




DATE JAN 6 1998

TOWN OF LEXINGTON — BOARD OF PUBLIC WORKS

SEWER DIVISION

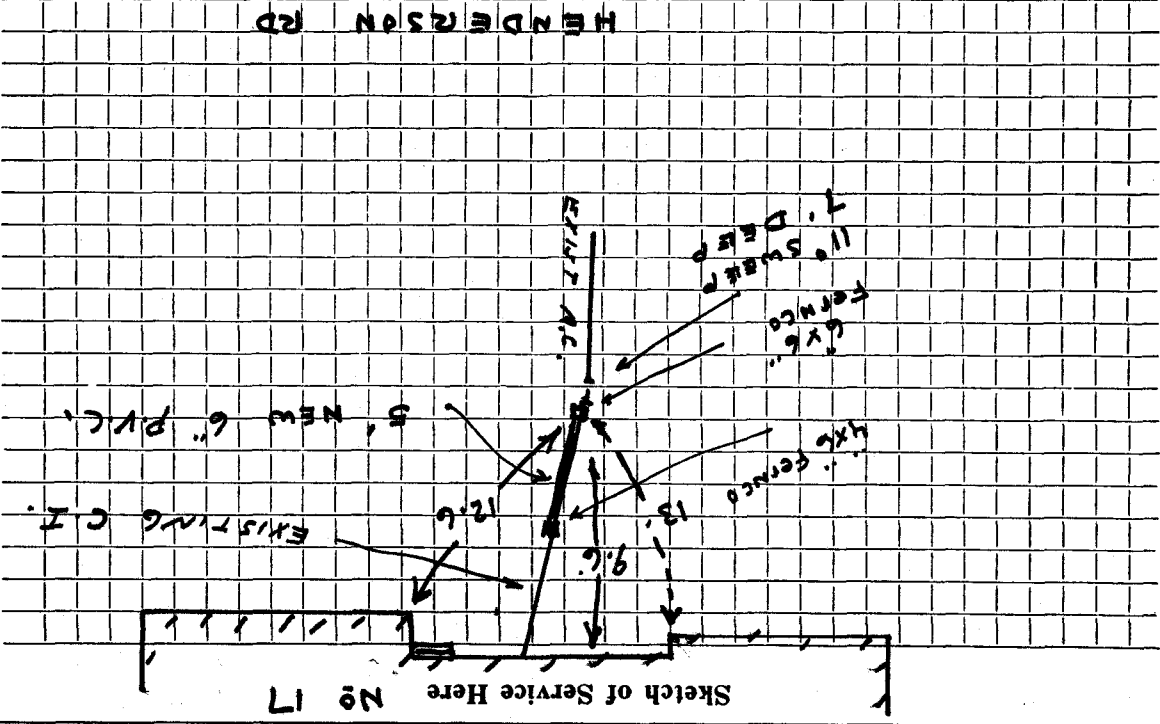

Work completed. BRUCE MCHEE

Street.

HENDERSON

Connection made in.

Remarks:

FIELD BOOK 97-5

T.M.

Name Homeland RealtyService No. 31Address 17 Henderson Rd.

## Location

Kind of Pipe

Size

Size of Main

Repair—Renewal—New Service

Location Comm 6-1-59.

Date	Material	Amount	Total	Date		Amount
1956	18½' 6" V.C. Sewer Pipe			4-15-59	Deposit	200.00
	installed by contractor @3.00		55.50	6-1-59	Retained	<del>24.85</del>
5-4-59	Labor	58 32		1956		175.15
	10% O. H.	5 83	64 15	18.6	6" Sewer Pipe V.C.	
	½ 2' 6" Transite Pipe @.70		29 40			
	1 11¼° Transite Bend		5 10			
	3 Hrs. Town Shovel @6.50		19.50			
	2 Hrs. Trucking @.75		1 50			
			175 15			
	Labor					

TOWN OF LEXINGTON—DEPT. OF PUBLIC WORKS


SEWER DIVISION

DATE .....

NO. ....

The undersigned applies for the construction of a particular sewer connecting No. ....  
 Street and hereby agrees to comply with the Rules and Regulations governing the construction and use of Particular  
 Sewers, as now or at any future time established by the Board of Selectmen.  
 Am't of estimate \$.....  
 Am't Paid \$.....

Owner .....

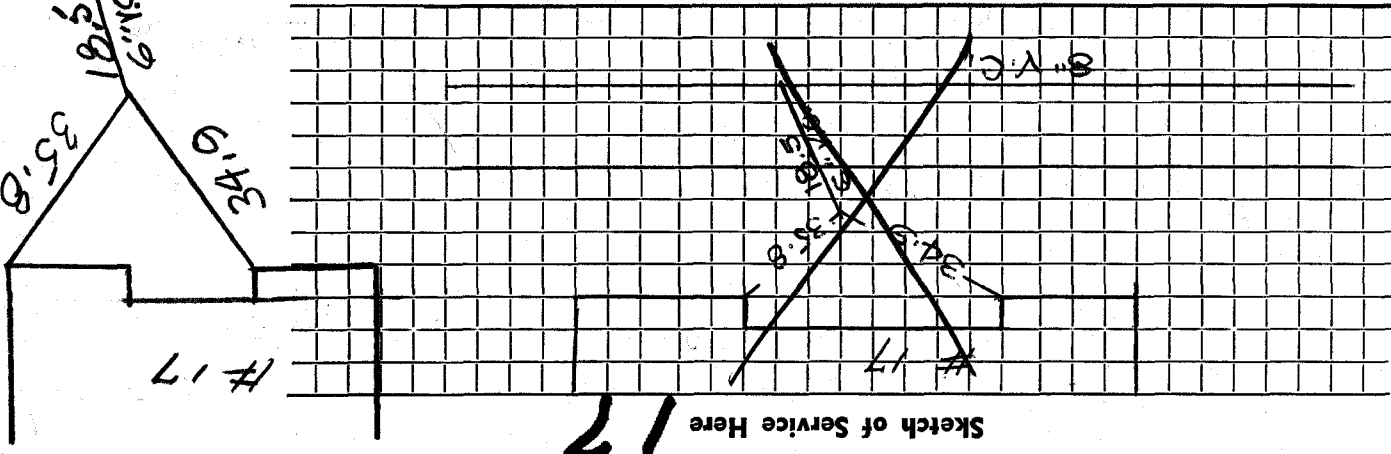

Sketch of Service Here

17

Note  
3:0 Chimney

Connection made in ..... Street.  
 Work completed ..... 8'' 19.V.C.  
 Remarks: