

Name Douglas W. Smith

Service No. 179

Address 7 Henderson Rd.

Location

Kind of Pipe

Size

Size of Main

~~Repair & Renewal~~ - New Service to curb

Location *Comm 12-14-59*


Date	Material	Amount	Total	Date	Amount
1956	22' 6" Sewer Pipe V.C.			9-18-59	250.00
	installed by contractor @3.00	67.50	67.50	<i>Deposit</i>	
10-15-59	Labor	62.83		<i>Paid</i>	9.76
	10% O.H.	6.28	69.11		259.76
	100' 6" Transite pipe @.70	70.00	70.00	1966	
	1 6" 1/8° Bend @7.60	7.60	7.60	22.6	6" Sewer Pipe V.C.
	150 Sewer Brick @4.20 per 100	6.30	6.30		
	1 20" Cesspool Cover & Frame	10.50	10.50		
	2 bags Cement @1.50	3.00	3.00		
	1 ton Sand	1.00	1.00		
	5 hrs. Pippin @4.50	22.50	22.50		
	3 labor. Trucking @.75	2.25	2.25		
		259.76	259.76		
				<i>Bill sent</i>	<i>12-14-59</i>
					<i>9.76</i>

TOWN OF LEXINGTON—DEPT. OF PUBLIC WORKS

SEWER DIVISION

DATE
The undersigned applies for the construction of a particular sewer connecting No.
Street and hereby agrees to comply with the Rules and Regulations governing the construction and use of Particular
Sewers, as now or at any future time established by the Board of Selectmen.
Am't of estimate \$.....
Am't Paid \$.....

Owner

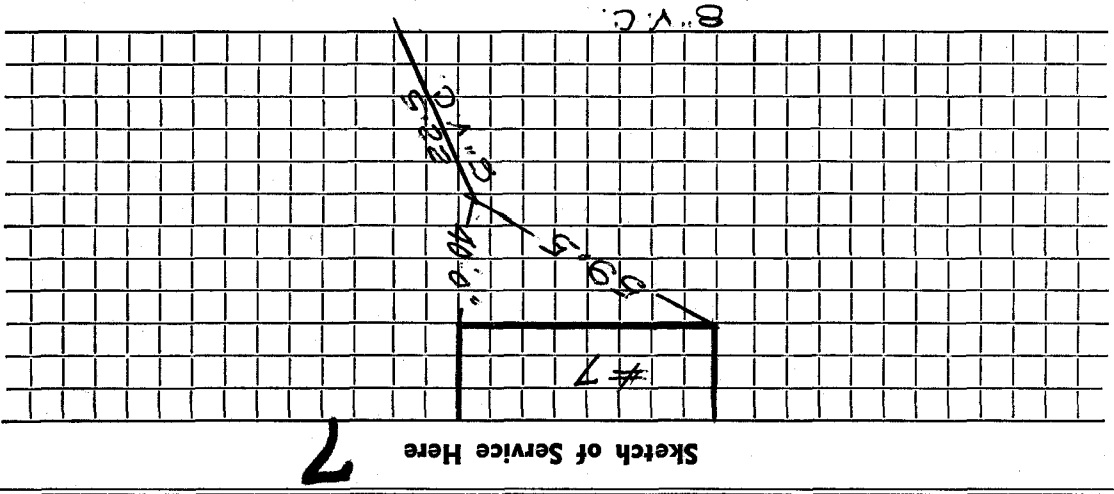

Sketch of Service Here

7

Connection made in Street.
Work completed 19..

Remarks: