




TOWN OF LEXINGTON—DEPT. OF PUBLIC WORKS  
**SEWER DIVISION**

DATE..... NO.....

The undersigned applies for the construction of a particular sewer connecting No.....  
 Street and hereby agrees to comply with the Rules and Regulations governing the construction and use of Particular  
 Sewers, as now or at any future time established by the Board of Selectmen.

Am't of estimate \$.....  
 Am't Paid \$.....

Owner.....

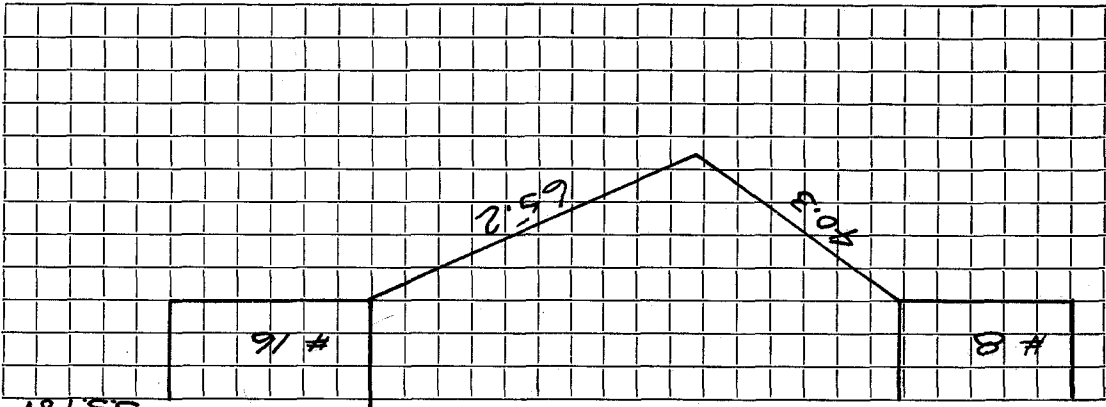

Sketch of Service Here

SS For # 8

Connection made in..... Street..... Work completed..... 19.....

Remarks:




DATE APRIL 24 1997

TOWN OF LEXINGTON — BOARD OF PUBLIC WORKS

SEWER DIVISION

Sketch of Service Here

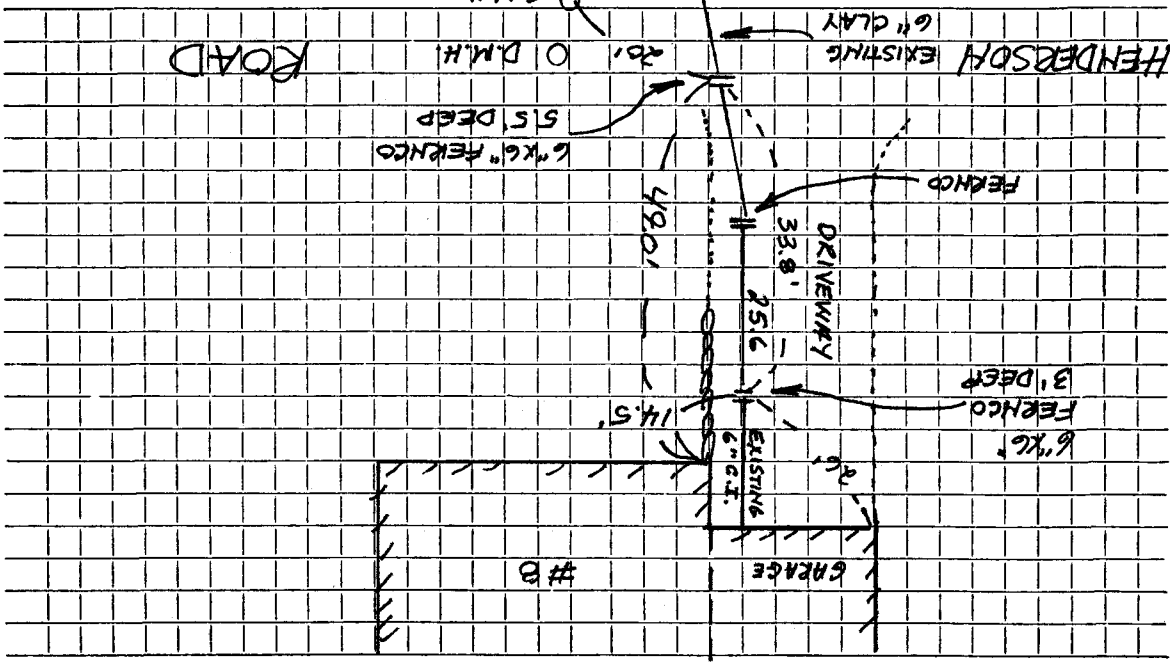

Connection made in HENDERSON ROAD Street. Work completed

Remarks: Original Service 11/3/56