

Name Ralph Hall

Service No.

Address 1 Heritage Drive

Location

Lot #10

Kind of Pipe

Size

Size of Main

~~Repair~~ Renewal - New Service

Lucente #1422  
John Melone & Sons - Permit #11144


Location

Date	Material	Amount	Total	Date	Amount
8/2/68	30' 6" Transite pipe				
8-22-69	40' 6" Transite pipe				
	10' 4" Cast Iron pipe			8-2-68	
					30' 6" Transite
					16" x 8" Wye

TOWN OF LEXINGTON — BOARD OF PUBLIC WORKS

SEWER DIVISION

Sketch of Service Here

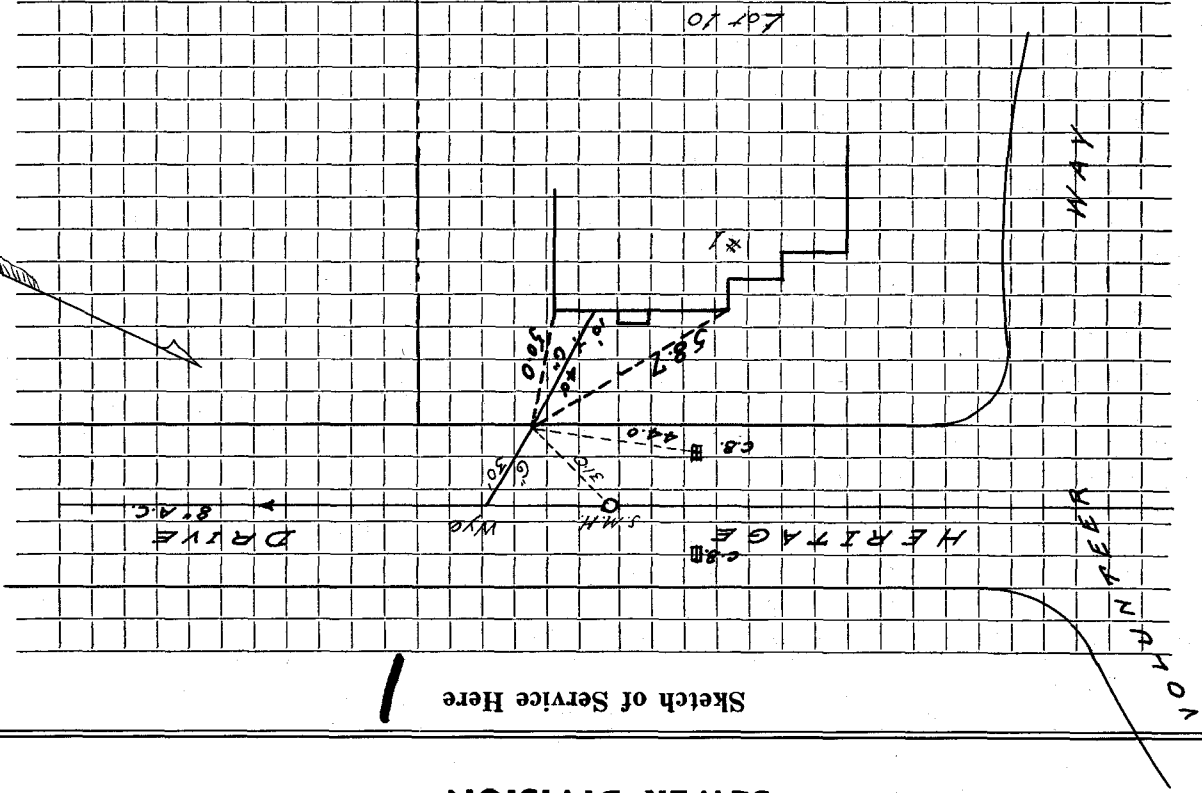

Connection made in ..... Street. Work completed .....  
Remarks: .....