




TOWN OF LEXINGTON — BOARD OF PUBLIC WORKS

SEWER DIVISION

DATE \_\_\_\_\_

Sketch of Service Here **15**

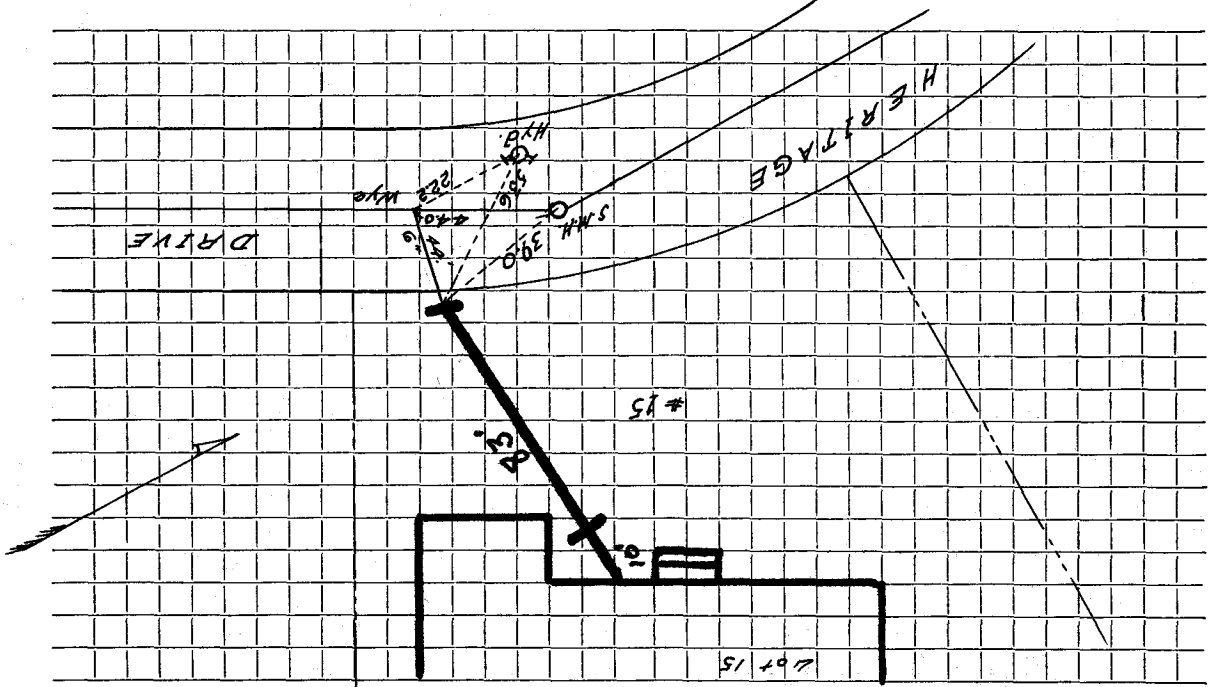

Work completed \_\_\_\_\_

Street \_\_\_\_\_

Connection made in \_\_\_\_\_

Remarks: ... *From wye* ... *5 ft from wye* ... *Transition* ... *43' 11"* ... *From wye*