


TOWN OF LEXINGTON — BOARD OF PUBLIC WORKS

SEWER DIVISION

DATE _____

19

Sketch of Service Here

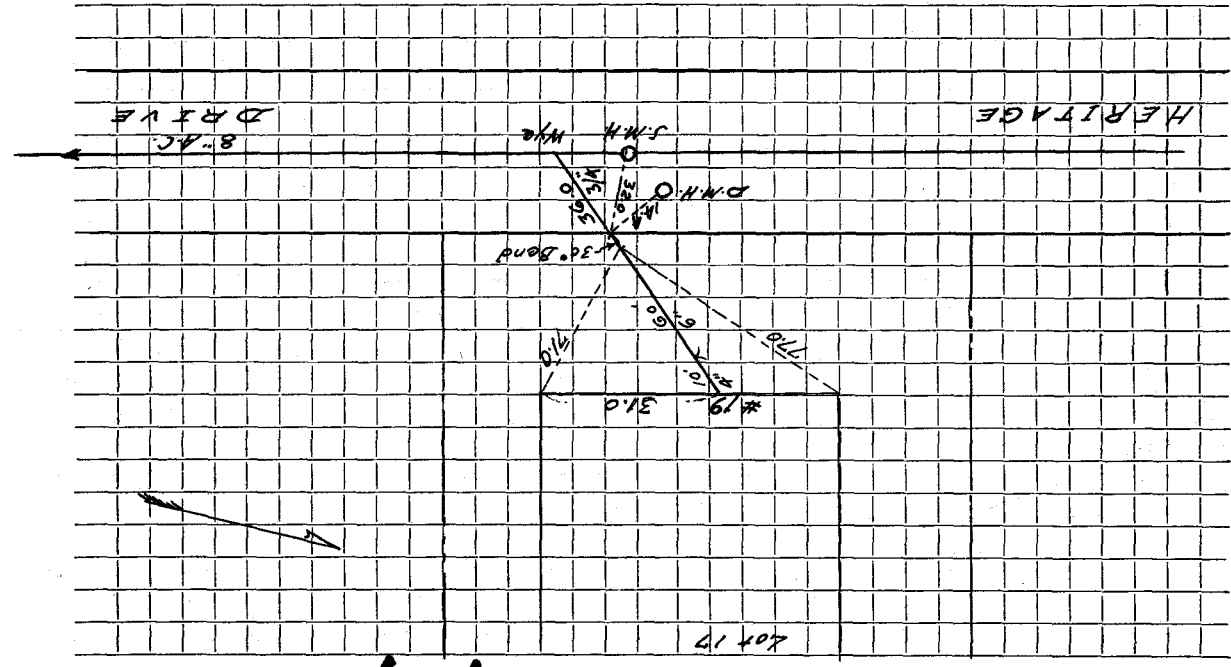

Connection made in Street. Work completed

Remarks: