




TOWN OF LEXINGTON — BOARD OF PUBLIC WORKS

SEWER DIVISION

DATE \_\_\_\_\_

22

Sketch of Service Here

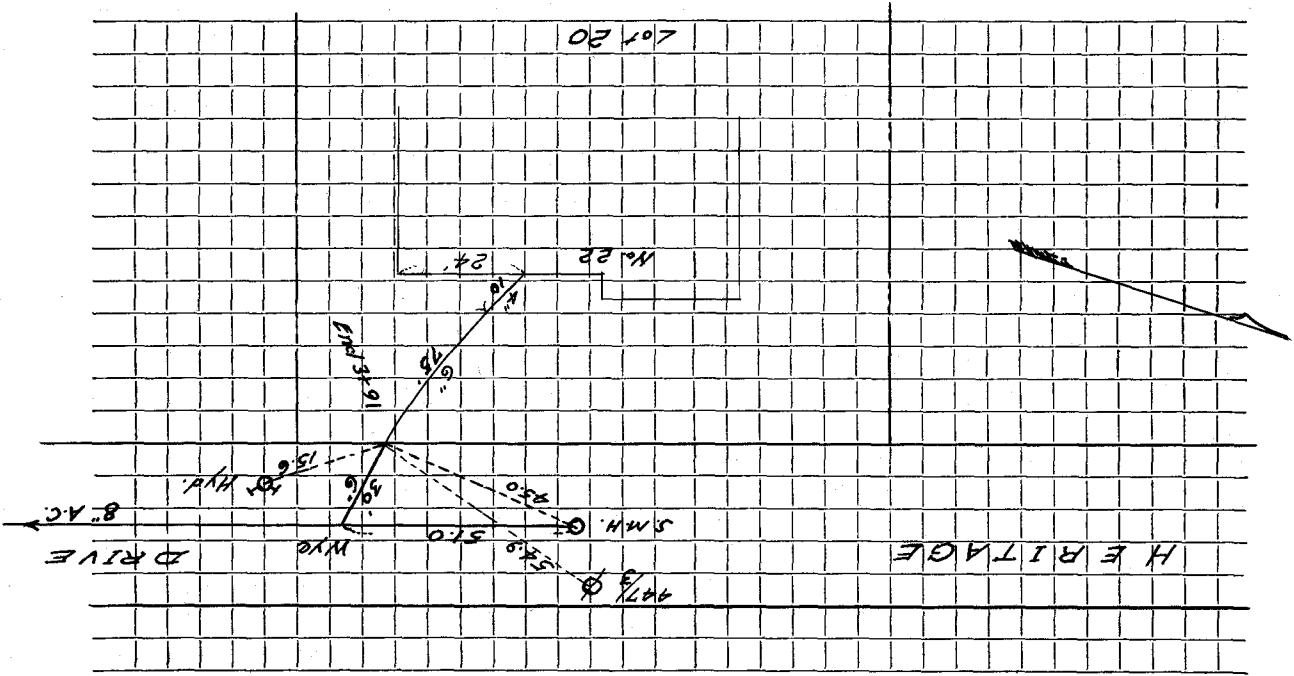

Connection made in ..... Street. Work completed .....  
 Remarks: .....