

Name Ralph Hall

Service No.

Address 4 Heritage Drive

Location

Lot #25

Kind of Pipe

Size

Size of Main

Lucente #1366
John Melone & Sons, Cont. - Permit #1143

Location


Date	Material	Amount	Total	Date	Amount
8/2/68	28' 6" Transite pipe				
6-6-69	6" Transite pipe			8-2-68	
10'	4" Cast Iron pipe			28'	
				1	
				6" Transite	
				6" X 8" Wye	

TOWN OF LEXINGTON — BOARD OF PUBLIC WORKS

SEWER DIVISION

DATE _____

Sketch of Service Here 

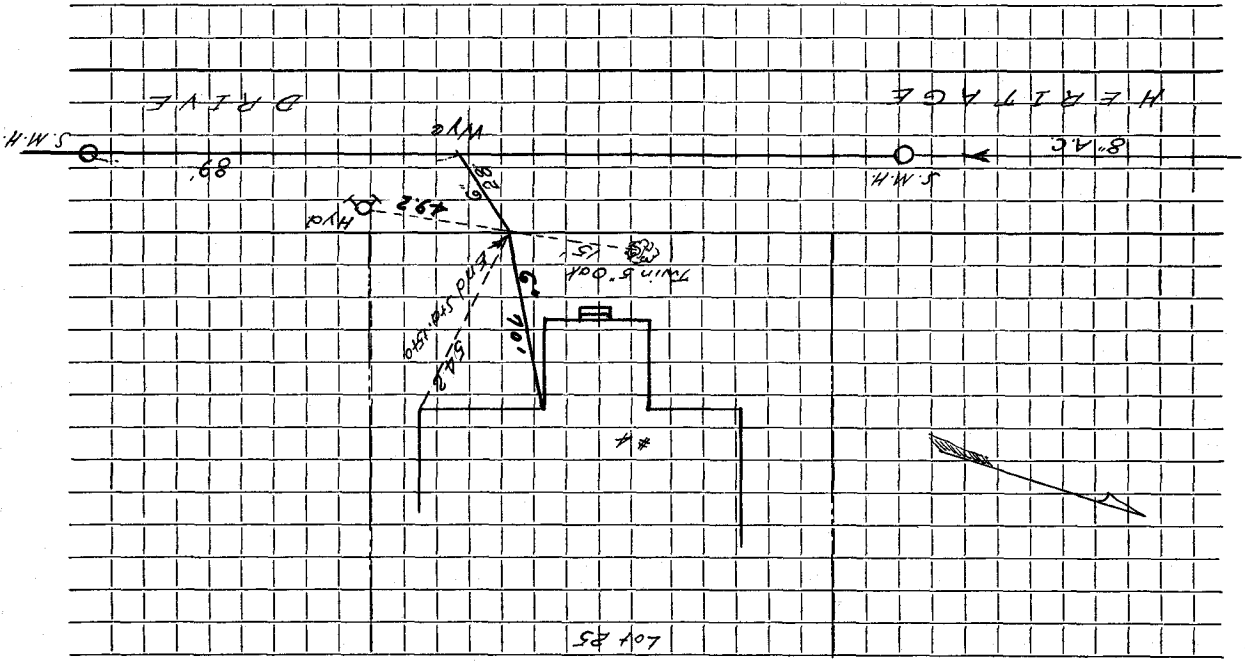

Connection made in Street. Work completed
Remarks: