

Name Ralph Hall

Address 5 Heritage Drive

Service No.

Address 5 Heritage Drive

Location

Lot #11

Kind of Pipe

Size

Size of Main

DeFlice #1786

Location

Permit #1142

Repair-Renewal-New Service

John Melone & Sons

Date	Material	Amount	Total	Date	Amount
8/2/68	30' 6" Transit pipe				
2-2-70	57' 6" Transit pipe				
	10' 4" Cast Iron pipe			8-2-68	
				30' 6" TRANSITE	
				1 6" X 8" WYE	


TOWN OF LEXINGTON — BOARD OF PUBLIC WORKS

SEWER DIVISION

DATE _____

5

Sketch of Service Here

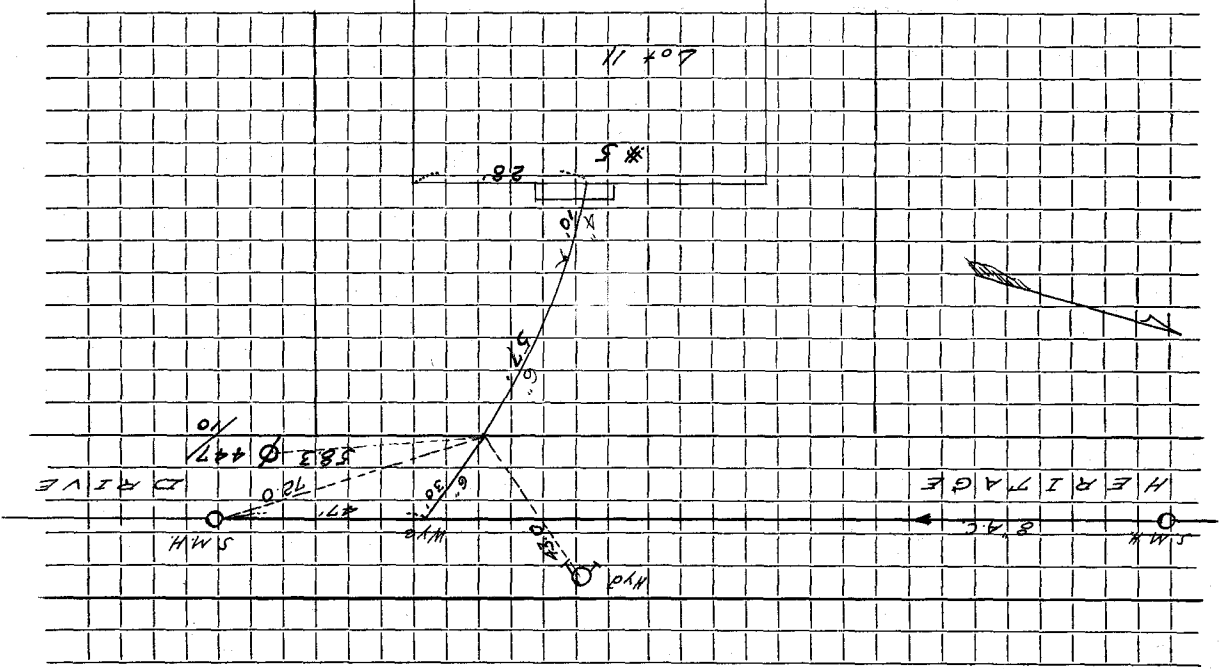

Work completed

Street

Connection made in

Remarks: