

Name Ralph Hall Service No.

Address 8 orlo Heritage Drive

Lot #23 Location

Kind of Pipe Size of Main

Deflice #1856 John Melone & Sons, Cont. Permit #1153 Location

Repsis**Renewal**New Service

Date	Material	Amount	Total	Date	Amount
8/2/68	27' 6" Transit pipe				
5-20-71	90' 6" Transit pipe			8-2-68	
	20' 4" Cast Iron pipe			27' 6" Transit	
				1 6" X 8" Wye	

TOWN OF LEXINGTON — BOARD OF PUBLIC WORKS


SEWER DIVISION

DATE _____

Sketch of Service Here

8

Lot 23

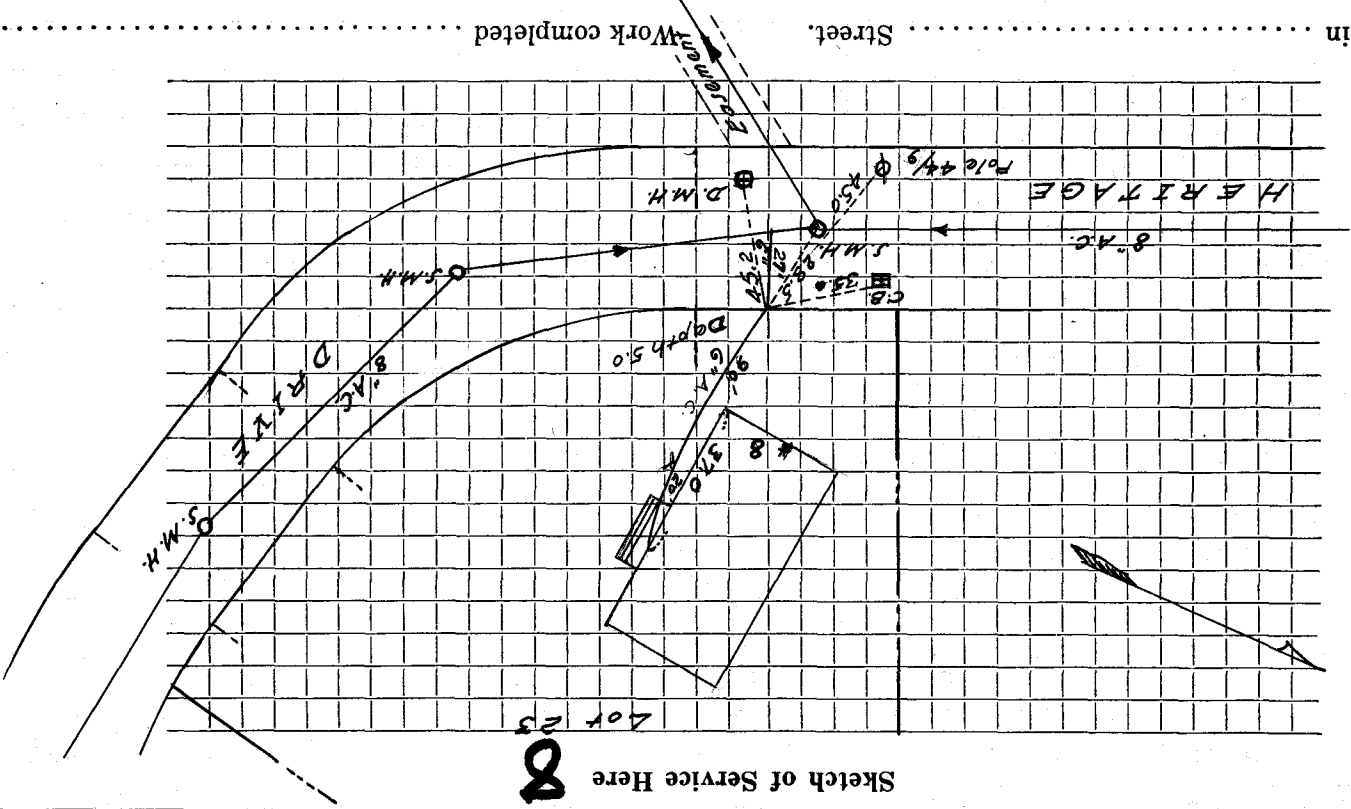

Connection made in
 Remarks: