

Name Morris Berman

Service No. 2

Address 6 Hibbert Street

Changed to #3 Hibbert St. per Eng. Dept. 9/18/68

Location

Kind of Pipe

Size

Size of Main

Repair Renewal - New Service

Location

Cam 6-1-59

Date	Material	Amount	Total	Date	Amount
4-16-59	Labor	91 10		3-9-59	1.50
	10% O. H.	9 11	100 21	6-1-59	2.50
29'	6" Transite Pipe @.70		20 30	6-23-59	21.53
1	6" 22 1/2" Transite Bend		6 21		
1	6" 1/8 Clay Elbow		1 88		1.80
4	Hrs. Town Shovel @.6.50		26 00		
2	Hrs. Trucking @.75		1 50		
1	Hr. Loader @3.00		3 00		
1	Hr. Trailer @3.00		3 00		
1	Hr. Trucking @3.00		3 00		
	15 x 3 Patch		<u>15 00</u>		
			180 10		


751.15-2-59 6-2-59 22.53

DATE \_\_\_\_\_

TOWN OF LEXINGTON — BOARD OF PUBLIC WORKS

**SEWER DIVISION**

Sketch of Service Here

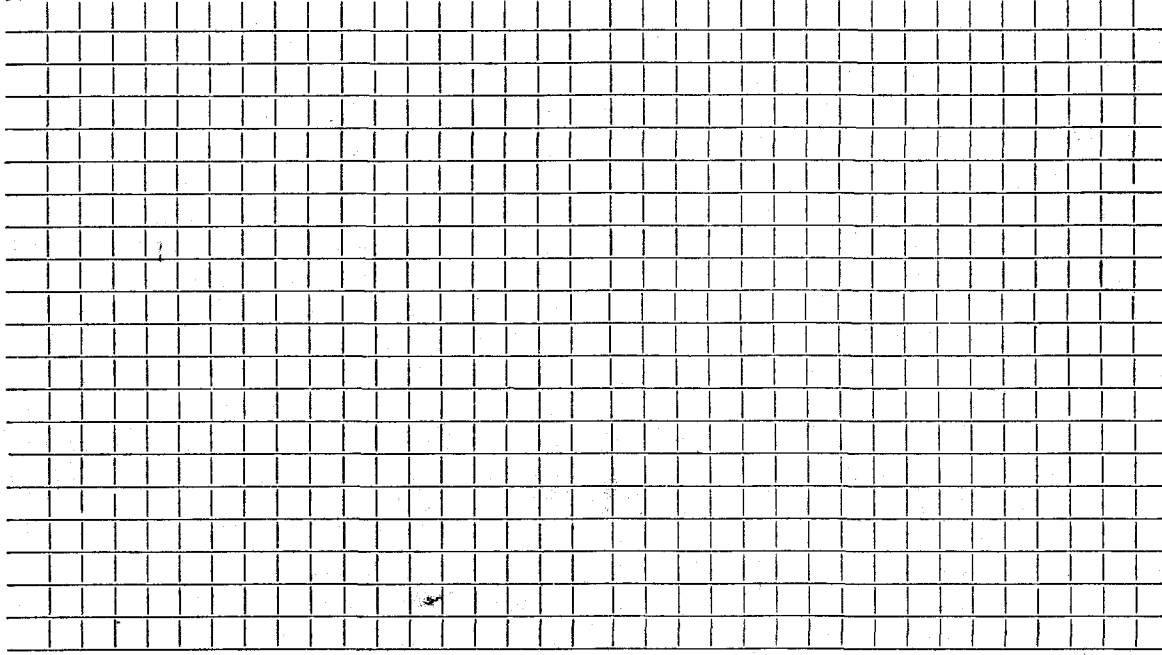

Connection made in ..... Street. Work completed .....  
Remarks: .....