


DATE _____

TOWN OF LEXINGTON — BOARD OF PUBLIC WORKS

SEWER DIVISION

Sketch of Service Here

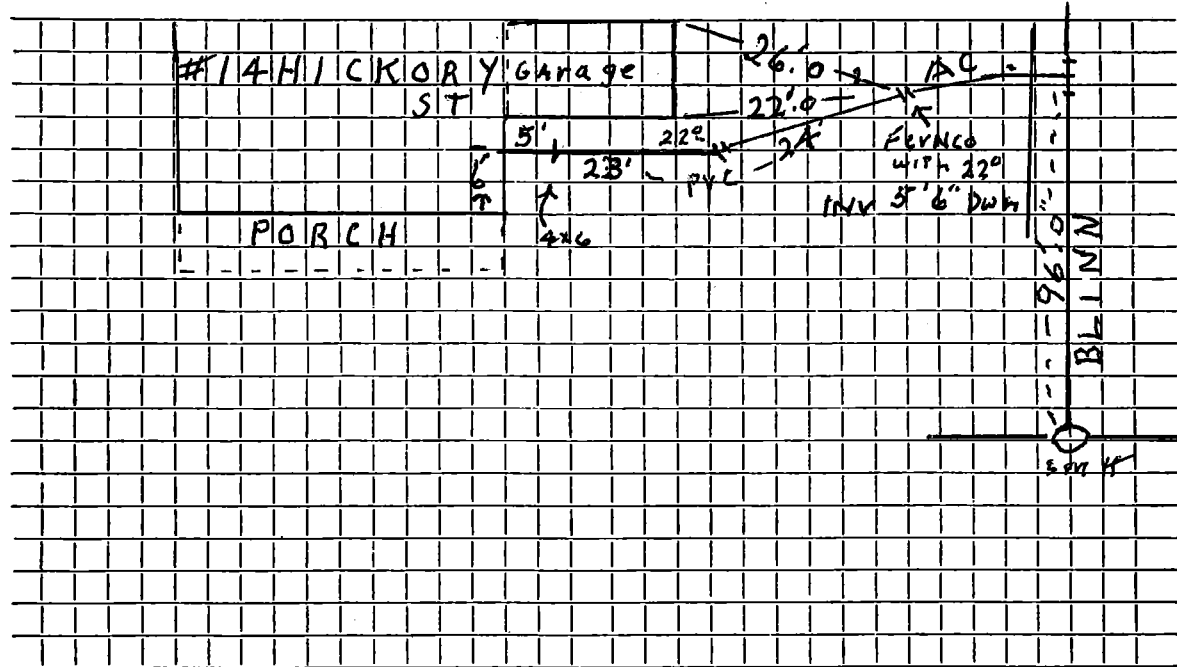

Connection made in Blinn RD Street. Work completed

Remarks: 5'-4" sch 40 - 47'-6" pvc - 2-22° bends exist. A.C. Stub

.....
.....