




4th corner ST.

TOWN OF LEXINGTON — BOARD OF PUBLIC WORKS

SEWER DIVISION

Sketch of Service Here

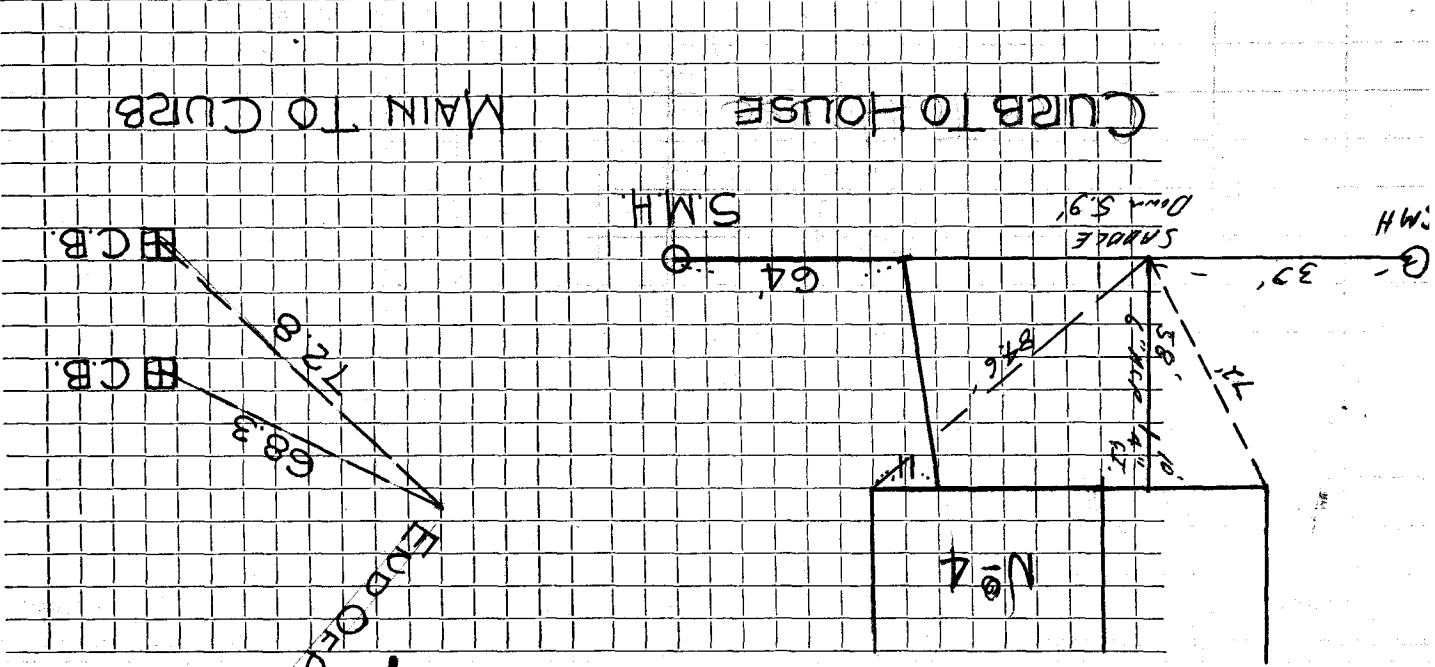

Connection made in Street.  
Work completed.  
Remarks: This house now has two sewer services.  
Addition built onto house.