

Name William Burns

Service No.

Address 5 Hickory Street

Lot #28 A

Location

Kind of Pipe

Size

Size of Main

~~Burns~~ ~~Burns~~ ~~vik~~ - New Service William Burns Permit #171

Location

1965

AUG 9

DeFlice Bros. Permit #463


Date	Material	Amount	Total	Date	Amount
Dec. 6-38	6" Transite pipe				
9-3-65	6" Transite pipe			12- - 69	
				38' 6" Transite	

TOWN OF LEXINGTON — BOARD OF PUBLIC WORKS
 SEWER DIVISION

DATE _____

Sketch of Service Here

5

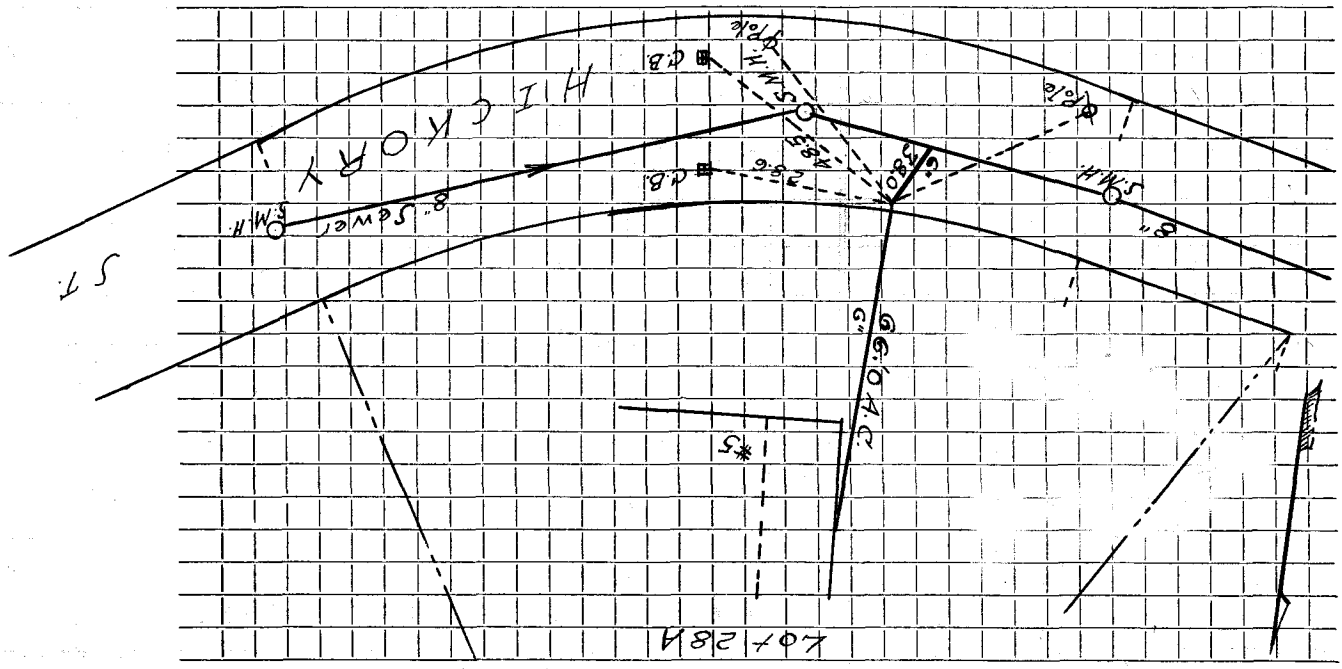

Connection made in Street. Work completed Remarks :