


TOWN OF LEXINGTON — BOARD OF PUBLIC WORKS

SEWER DIVISION


DATE _____

Sketch of Service Here

8

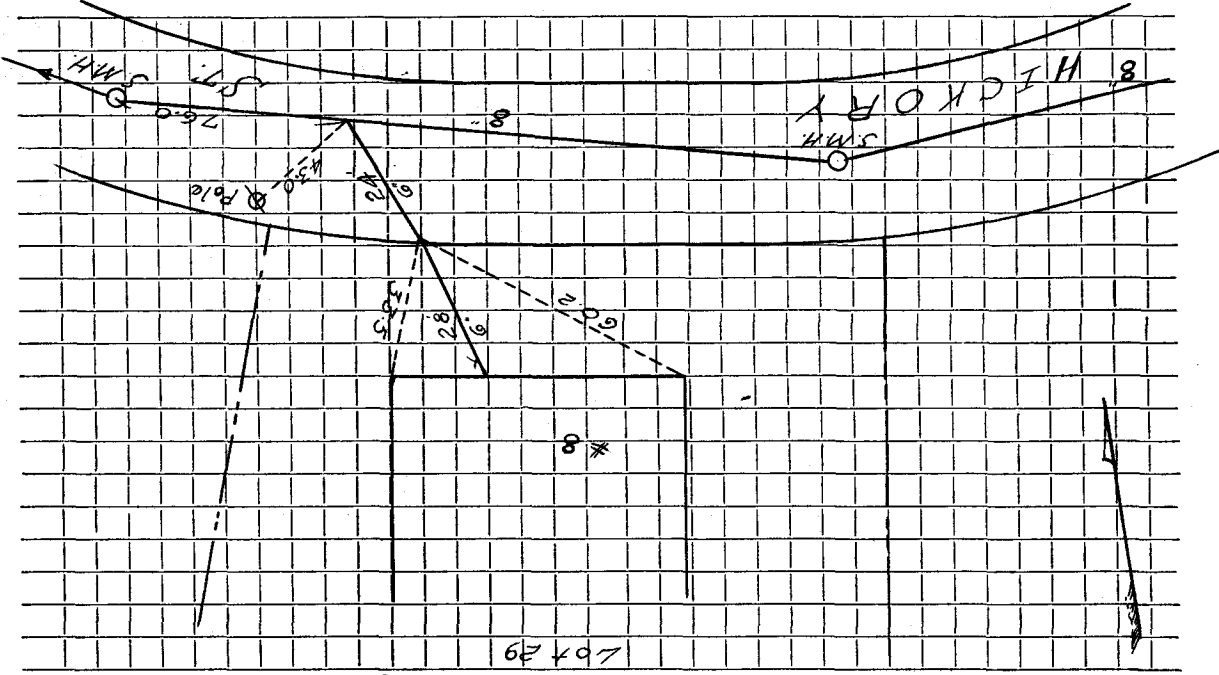

Lot 29

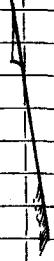

* 6

8 HICKORY

571 S.M.H.

26.9

4.50

9/12

2.8

9/12

3.05

9/12

4.0

9/12

Work completed

Street.

Connection made in

Remarks: