

Name

Service No.

Address

11 Highland Ave.

Location

Kind of Pipe

Size

Size of Main

Repair—Renewal—New Service

Location


Date	Material	Amount	Total	Date	Amount
10-8-29	<del>54' 4" Sewer Pipe</del>				
	<del>10' 4" Soil Pipe</del>				
	<del>1 1/8" Bend</del>				
	<del>1 4" X 6" Reducer</del>				
5/05	46' PVC 6"				
	2 4X6 Fences				
	1 wire for drain out				
	One 5 1/4" TB				

1-12-77 ROOTS & PLUGGED INSIDE  
 3-26-70 RnTc

DATE \_\_\_\_\_

**TOWN OF LEXINGTON — BOARD OF PUBLIC WORKS**  
**SEWER DIVISION**

Sketch of Service Here

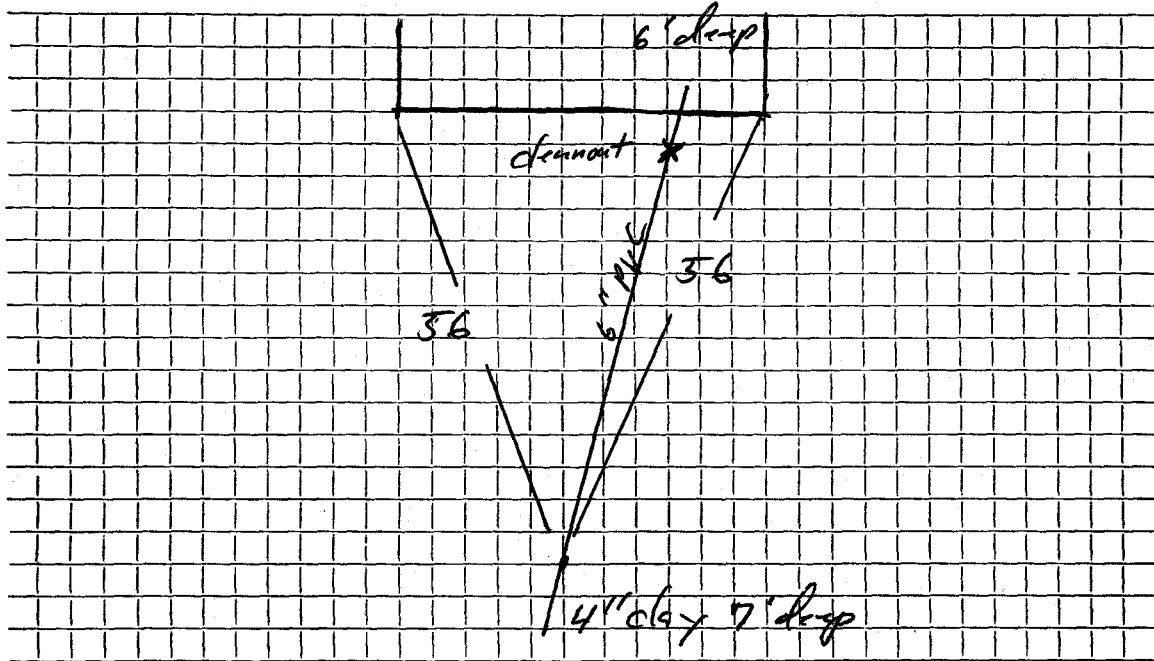

Connection made in ..... Street. Work completed .....

Remarks: .....  
.....  
.....