

Name Dr. G. W. Day

Service No. 20 100

Address 2142 Mass. Avenue

2142 Mass. Ave.

Location 2142 Mass. Ave

Kind of Pipe

Size

Size of Main

Repair—~~Renewal~~ New Service

Location

Date	Material	Amount	Total	Date	Amount
10/14/38					
<i>from 11-13/38</i>	1 1/2 hrs. @ 65¢	98		November 7, 1938	15 00
	9 1/2 " 60¢	5 70			
	2 " 55¢	1 10			
	8 " 50	4 00	11 78		
	10% Overhead		1 78		
	10' 6" Sewer Pipe @ 20¢		2 00		
	1 6 x 4 Reducer		1 00		
	Joint. Compound		60		
	2 hrs. trucking @ 75¢		1 50	<i>Belknap</i>	
			\$18 66		
	Charge: \$15.00.				
	Labor			5-17-67	PAPERS

Hadley Press, Inc., Lexington

TOWN OF LEXINGTON—BOARD OF PUBLIC WORKS
SEWER DIVISION

DATE _____

NO. _____


The undersigned applies for the construction of a particular sewer connecting No. _____
Street and hereby agrees to comply with the Rules and Regulations governing the construction and use of Particular
Sewers, as now or at any future time established by the Board of Selectmen.

Am't. of Estimate \$ _____

Am't. Paid \$ _____

Owner

Sketch of Service Here

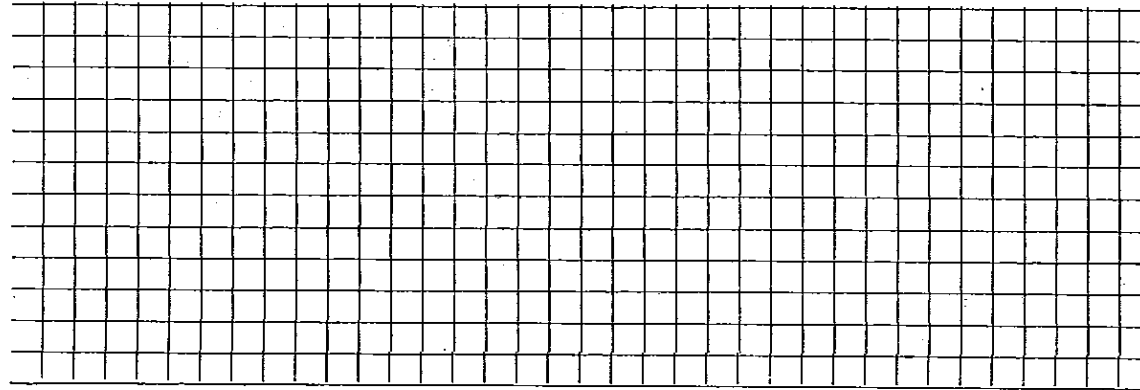

Connection made in _____ Street.

Work completed _____ 19

Remarks: