

Name J. G. Realty Trust

Service No. 3

Address 2150 Mass. Avenue

2150 Mass. Ave.

Location

Kind of Pipe

Size

Size of Main

~~XXXXXXX~~ ~~Renewal~~ ~~XXXXXXX~~ New Service

W.O. #292 DeFlice #3368

Location

MAY 21 1979

Date	Material	Amount	Total	Date	Amount
5-9-79	Labor	111.00		3-10-79	375.00
	10% O.H.	11.00	122.00		92.81
	20' 6" Transite pipe @1.91		38.20		382.19
	1 6" x 45° Bend		5.69		
	1 6" x 30° Bend		11.22		
	1 6" Plug		2.95		
	1 6" x 8" Saddle		22.29		
	2 ton Fine Gravel @ 2.25		4.50		
	3 hrs. Trucking @3.00		9.00		
	2 hrs. Backhoe @6.50		13.00		
	Hot Top 5' x 16'		53.34		
			282.19		
5-23-79	39' 6" Transite pipe				
	10' 4" Cast Iron pipe				


DATE \_\_\_\_\_

TOWN OF LEXINGTON — BOARD OF PUBLIC WORKS

SEWER DIVISION

Sketch of Service Here

2150

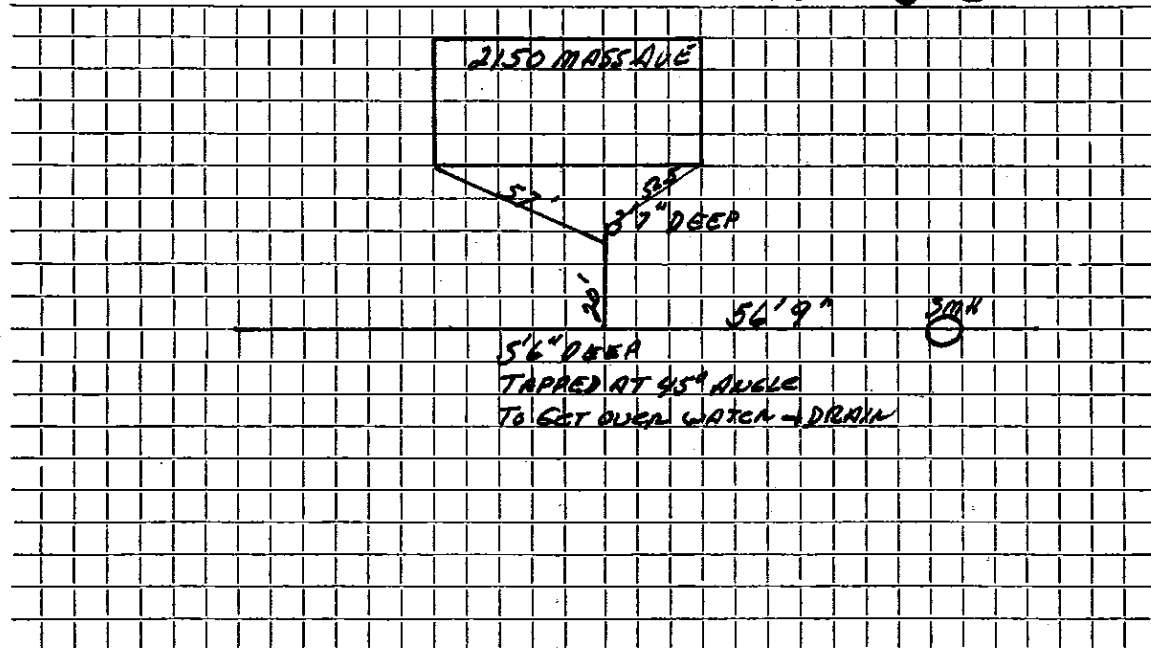

Connection made in ..... Street. Work completed .....

Remarks: .....  
.....  
.....