

Name William R. McEwen, Jr.

Service No. 49

Address 2160 Massachusetts Avenue

2160 Mass. Ave.

Location

Kind of Pipe

Size

Size of Main

~~Repair~~ ~~Renewal~~ ~~New Service~~

W. O. # 9609

Location JUL 31 1972


Date	Material	Amount	Total	Date		Amount
5/3/72	Labor	127 01		4-25-72	Deposit	800 00
5/4/72	"	48 31		5-31-72	Refund	381 52
5/18/72	"	83 60	258 92			518 48
	10% O.H.		25 89			
					OUTSIDE	
	120' 6" Transite pipe .90		108 00	5/3/72	Labor	29 31
	1 6x6 Wye		9 37	5/4/72	"	107 47
	2 11 1/2" Elbows 3.95		7 90	5/5/72	"	33 39
	1 11 1/2" Sweep		4 65		5' 6" Transite pipe	4 50
	6 Yds. Loam 3.50		21 00		17' 6" " " .90	15 30
	20 Lbs. Seed 1.10		22 00		1/2 Bag cement 1.95	8 98
	7 1/2 Hrs. Shovel 6.50		48 75		1 Ton Cold patch	00
	4 Hrs. Truck 3.00		12 00		2 Ton hot top 7.45	14 90
					5 1/2 Hrs. Shovel 4.00	22 00
					1 1/2 Hrs. Compressor 3.00	4 50
					4 Hrs. Truck 3.00	12 00
					1/2 Hr. " 1.50	75
					1/2 Hr. Roller 2.00	1 00
						254 10

TOWN OF LEXINGTON — BOARD OF PUBLIC WORKS

SEWER DIVISION

Sketch of Service Here

2160

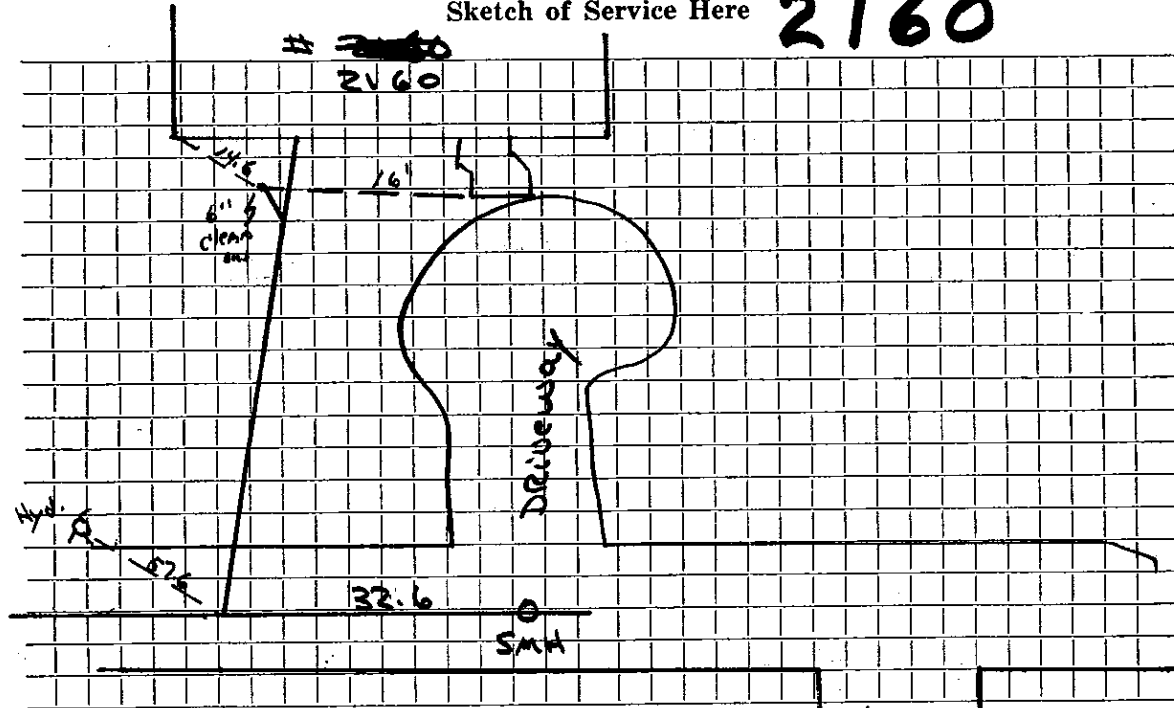

Connection made in Street. Work completed.....

Remarks: Original Service 5-22-28.....

.....
.....