

Name Katherine Ross

Service No.

4 717

Address 2173 Mass. Ave.

2173 Mass. Ave.

Location 2173 Mass. Ave.

Kind of Pipe		Size	Size of Main		
<del>Repair</del> <del>Renewal</del> — New Service		Location			
Date	Material	Amount	Total	Date	Amount
5/11/31	Owner digs trench (to Middle of street) supplies own pipe and stock, and lays pipe and makes connection.				
	Labor				

Hadley Press, Inc., Lexington

TOWN OF LEXINGTON—BOARD OF PUBLIC WORKS

SEWER DIVISION

DATE May 10, 1931

NO. \_\_\_\_\_

The undersigned applies for the construction of a particular sewer connecting No. 2173 Mass Ave. Street and hereby agrees to comply with the Rules and Regulations governing the construction and use of Particular Sewers, as now or at any future time established by the Board of Selectmen.

Am't. of Estimate \$ \_\_\_\_\_


Am't. Paid \$ \_\_\_\_\_

*Owner digs trench to Centre of Street*

*Anthony Ross*

Owner

Sketch of Service Here

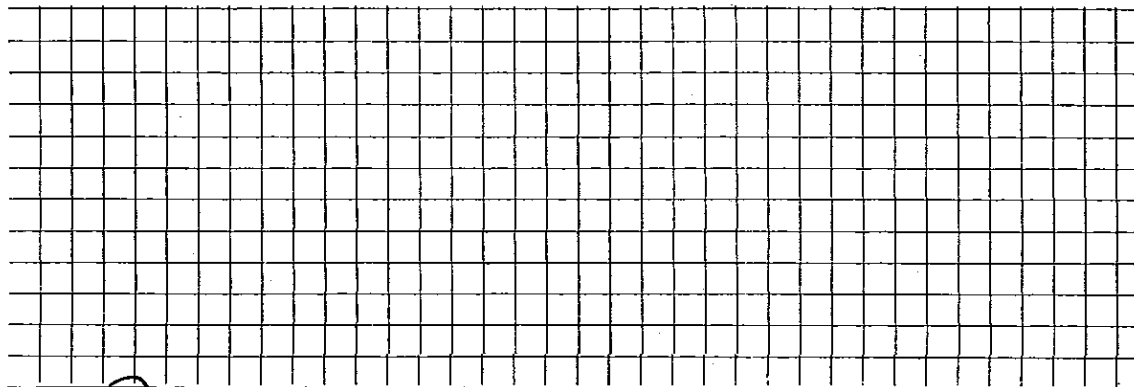

Connection made in Sedar Street.

Work completed \_\_\_\_\_ 19

Remarks: