


DATE AUGUST 14, 1997

TOWN OF LEXINGTON — BOARD OF PUBLIC WORKS
SEWER DIVISION

Sketch of Service Here

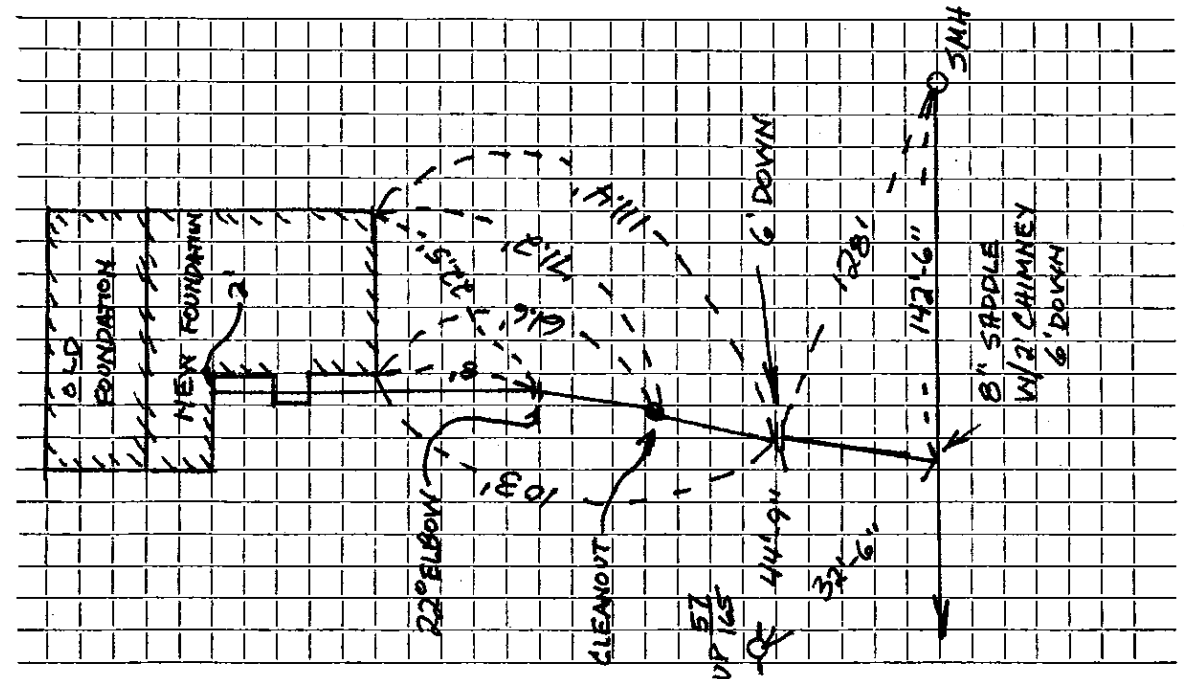

Connection made in MASSACHUSETTS AVENUE Street. Work completed

Remarks:
.....
.....

RMK 07-2