

Name Mary H. Green

Service NO. 101

Address 2195 Mass. Avenue, Lexington

**2195 Mass. Ave.**

Location **2195 Mass. Ave.**

Kind of Pipe		Size		Size of Main		Location	
<del>Repairs</del> —New Service							
Date 1942	Material	Amount		Total		Date	Amount
June 11	18 hrs. @ 60¢	10	80			May 26, 1942	Deposited 15.00
Com. 7/6/42	27 " @ 65¢	17	55	✓	30 45	July 16, 1942	Refunded 11.21
	3 " @ 70¢	2	10	✓	3 05		
	10 % Overhead			✓	5 12		
	32' 6" Sewer Pipe @ 16¢			✓	1 92		
	Jointing compound			✓	4 50		
	Compressor - 2 hrs. @ 2.25			✓	1 25		
	Tractor - 1 hr.			✓	1 50		
	Trucking - 2 hrs. @ 75¢				16 00		
	Trench repairs				63 79		
	Labor						

Hadley Press, Inc., Lexington

TOWN OF LEXINGTON—BOARD OF PUBLIC WORKS  
SEWER DIVISION

DATE May 26, 1942

NO. \_\_\_\_\_

The undersigned applies for the construction of a particular sewer connecting No. 2195 Mass. Ave. Street and hereby agrees to comply with the Rules and Regulations governing the construction and use of Particular Sewers, as now or at any future time established by the Board of Selectmen.


Am't. of Estimate \$ 75<sup>00</sup>

Am't. Paid \$ \_\_\_\_\_

Mary W. Green Owner

Sketch of Service Here

**2195**

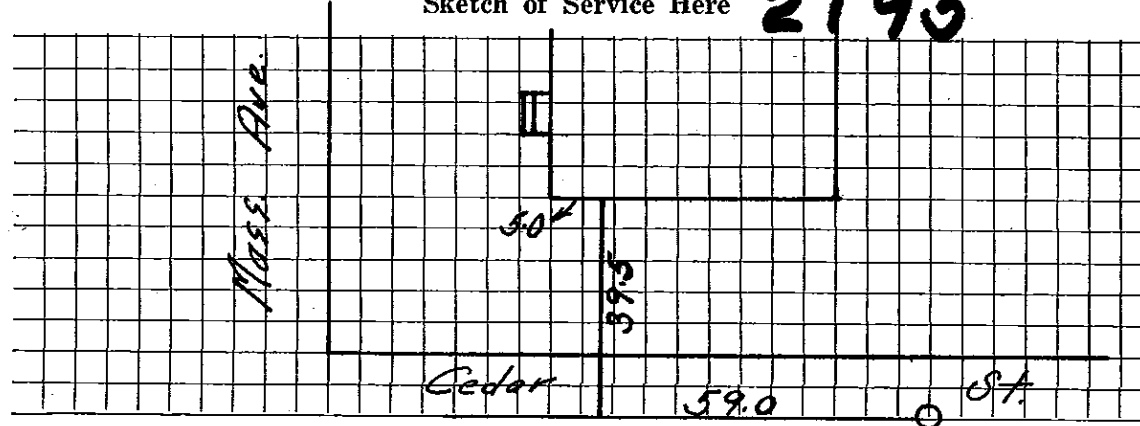

Connection made in \_\_\_\_\_ Street.

Work completed \_\_\_\_\_ 19

Remarks: