

Name David McGavern

Service No. 44

Address 2209 Mass. Avenue

2209 Mass. Ave.

Location

Kind of Pipe J.M.Lucente Permit #A243

Size

Size of Main

Repair—Renewal—New Service W.O. #2130


Location JUL 25 1966

Date	Material	Amount	Total	Date	Amount	
4/25/66	Labor	107.07		4-18-66	Deposit	150 00
5/6/66	"	68.25		7-25-66	Paid by W.H.P. 18	75 00
5/2/66	"	25.64		2-9-67	Paid	50 00
5/19/66	"	26.24	227.20	3-7-67	Paid	59 79
	10% O.H.	22.72	249.92	3-14-67	Paid	10 00
	13' 6" Transite pipe @.82		10.66			344 79
	9 bags cement @1.55		13.95			
	1 doz bricks		.51			
	2 ton sand		2.00			
	8 hrs. Trucking @3.00		24.00			
	2 hrs. Town Shovel @6.50		13.00			
	2 hrs. Compressor @5.00		10.00			
	½ hr. Front End Loader @4.00		2.00			
	1 hr. Roller		3.00			
	1 hr. Trailer		2.00			
	2½ ton Hot Top @5.50		13.75			
5/17/66	25' 6" Transite pipe		344.79			

TOWN OF LEXINGTON — BOARD OF PUBLIC WORKS

SEWER DIVISION

Sketch of Service Here **2209**

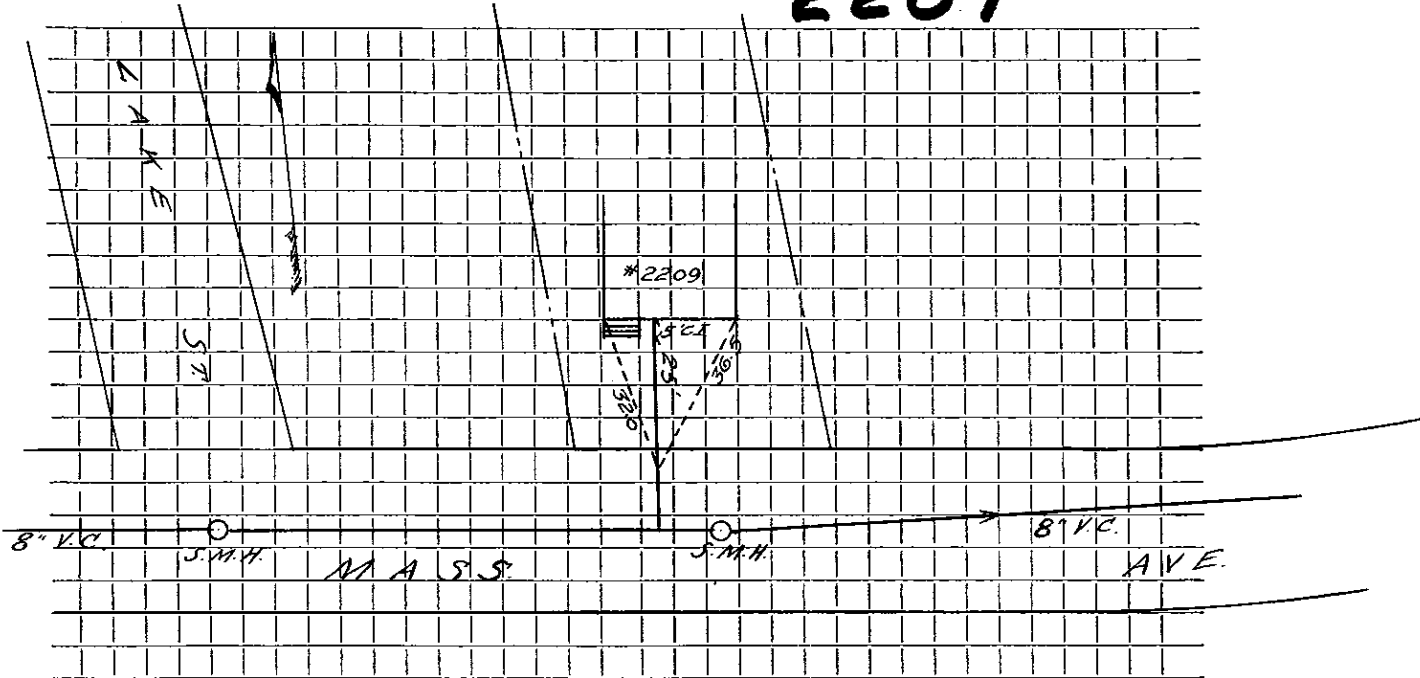

Connection made in Street. Work completed

Remarks:
.....
.....