

Name Mr. George M. Fuller

Service No. 15 1723

Address ~~63 Lexington St., Waverley~~

2210 Mass. Ave.

Location 2210 Mass. Ave.,

Kind of Pipe

Size

Size of Main

~~Repair - Renewal~~ - New Service

Location

Date	Material	Amount	Total	Date	Amount
<i>P. 12-22-31</i>	108' 6" Sewer Pipe @.25	27 00			
<i>for 12/4/09</i>	1 4" Iron Y	5 95		<i>Oct. 22 1931 - Cash</i>	<i>121 25</i>
	Sulphur & Jute	4 32		<i>Jan. 26 1932 - Cash</i>	<i>2 84</i>
	Trucking	75			
	2 St. Dyn. @ .25	50			
	4 Caps @ .14	56			
	2 Hrs. Comp. @ 3.00	<u>6 00</u>	45 08		
<i>Hadley Press, Inc., Lexington</i>					
<i>11/7/31</i>	114 Hrs. Labor @.55	62 70			
	10 " " @.60	<u>6 00</u>	68 70		
	15% Overhead		<u>10 31</u>		
	Labor		124 09		

TOWN OF LEXINGTON - BOARD OF PUBLIC WORKS
SEWER DIVISION

DATE June 9, 1931.

NO. _____


The undersigned applies for the construction of a particular sewer connecting No. Mass. Ave.
Street and hereby agrees to comply with the Rules and Regulations governing the construction and use of Particular
Sewers, as now or at any future time established by the Board of Selectmen.

Am't. of Estimate \$ _____

Am't. Paid \$ _____

Geo M Fuller Owner

Sketch of Service Here

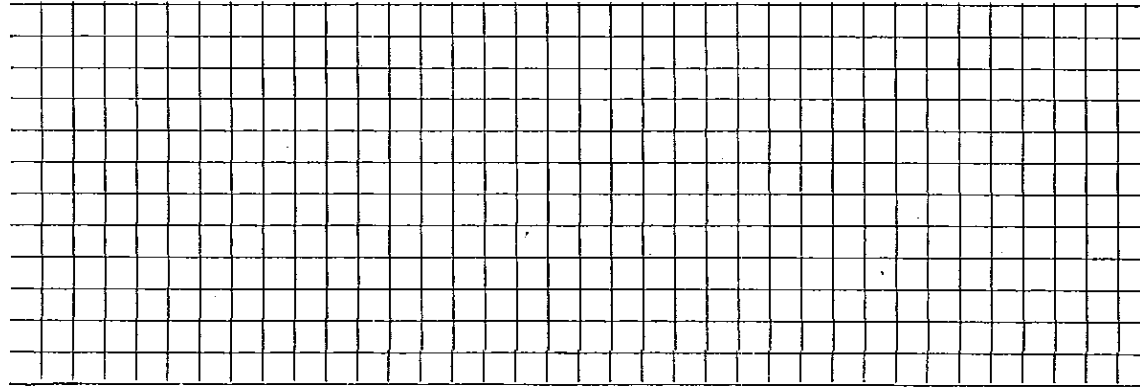

Connection made in _____ Street.

Work completed _____ 19

Remarks: