

Name Breslin Store

Service No. 1064Address 2219 Mass Ave2219 Mass. Ave.

Location 2219 Mass. A venue

Kind of Pipe		Size		Size of Main	
<del>Repairs</del> <del>Renewal</del> - New Service				Location	
Date	Material	Amount	Total	Date	Amount
6/16/47	Labor	42 47		6/11/47	90 00
6/17/47	"	34 00		April 12 - 18	28 67
6/18/47		7 35	83 82		118 67
	10% Overhead		8 38		
	26' 6" Sewer Pipe @ .26		6 76		
	Joint Compound		1 56		
	4 Exploders @ 11		44	Bill sent - 6-18	
	1 lb. Dynamite @ .21		21		
	1 hr. Compressor		1 75		
	1 hr. Trucking		75		
	Patching 15x3		15 00		
	<del>labor</del>		118 67		

TOWN OF LEXINGTON—DEPT. OF PUBLIC WORKS

SEWER DIVISION

DATE .....

NO. ....


The undersigned applies for the construction of a particular sewer connecting No. ....  
Street and hereby agrees to comply with the Rules and Regulations governing the construction and use of Particular  
Sewers, as now or at any future time established by the Board of Selectmen.

Am't of estimate \$.....

Am't Paid \$.....

..... Owner

Sketch of Service Here **2219**

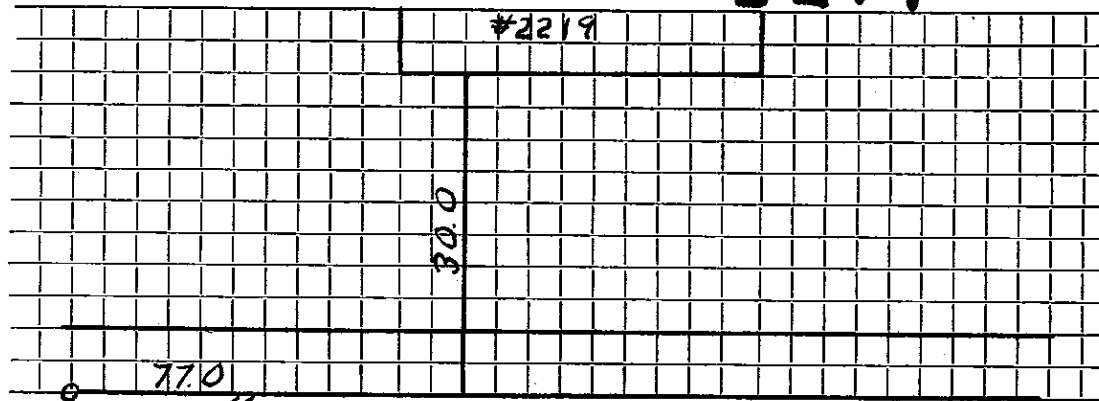

Connection made in ..... Street.

*Ave.* Work completed ..... 19..

Remarks: