

Name Edwin J. Breslin

Service No. 124

Address 2227 Mass. Avenue

2227 Mass. Ave.

Location

Kind of Pipe

Size

Size of Main

Repair—Renewal—New Service Lexington Sewerage #827


Location Comm 10-30-67

Date	Material	Amount	Total	Date	Amount
10-67	14' 6" Transite pipe @7.00		98.00	10-10-67	98.00
10-18-67	20' 6" Transite pipe				
	5' 4" Cast Iron pipe			67	
				14' 6" Transite	

H. B. H. 18501

TOWN OF LEXINGTON — BOARD OF PUBLIC WORKS
SEWER DIVISION

Sketch of Service Here **2227**

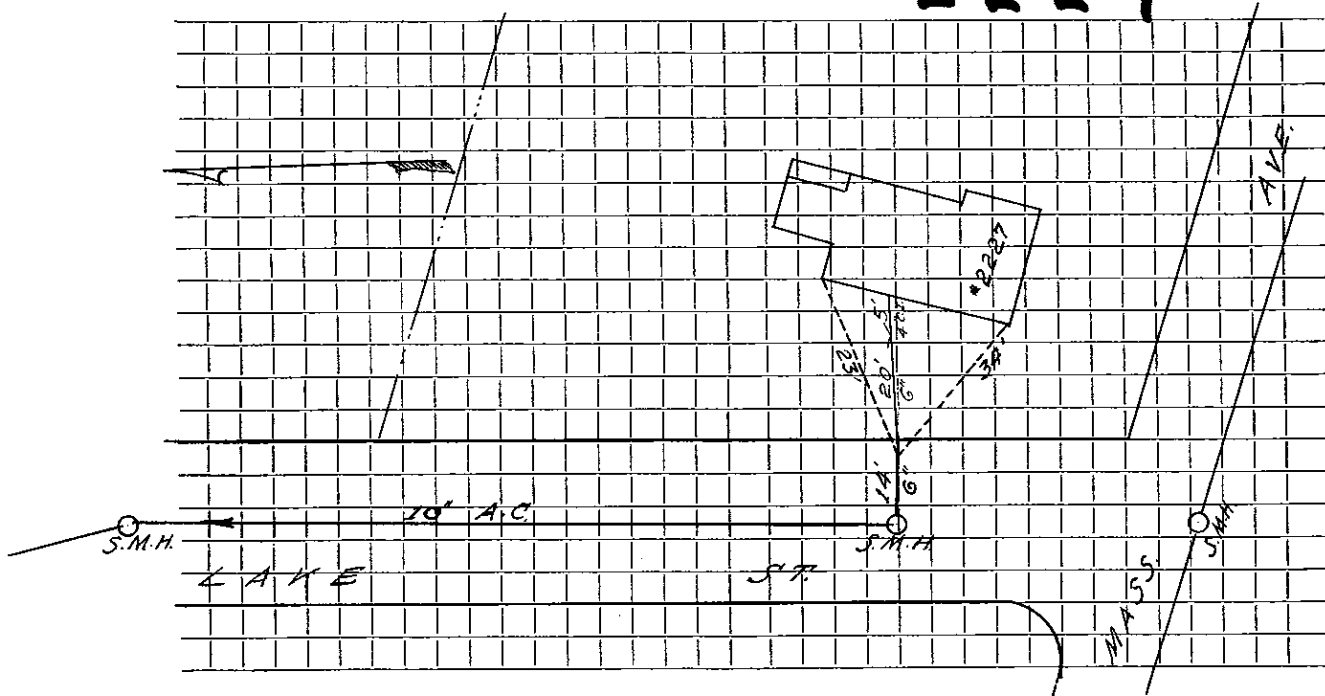

Connection made in Street. Work completed

Remarks:
.....
.....