


DATE _____

TOWN OF LEXINGTON — BOARD OF PUBLIC WORKS
SEWER DIVISION

Sketch of Service Here **2261**

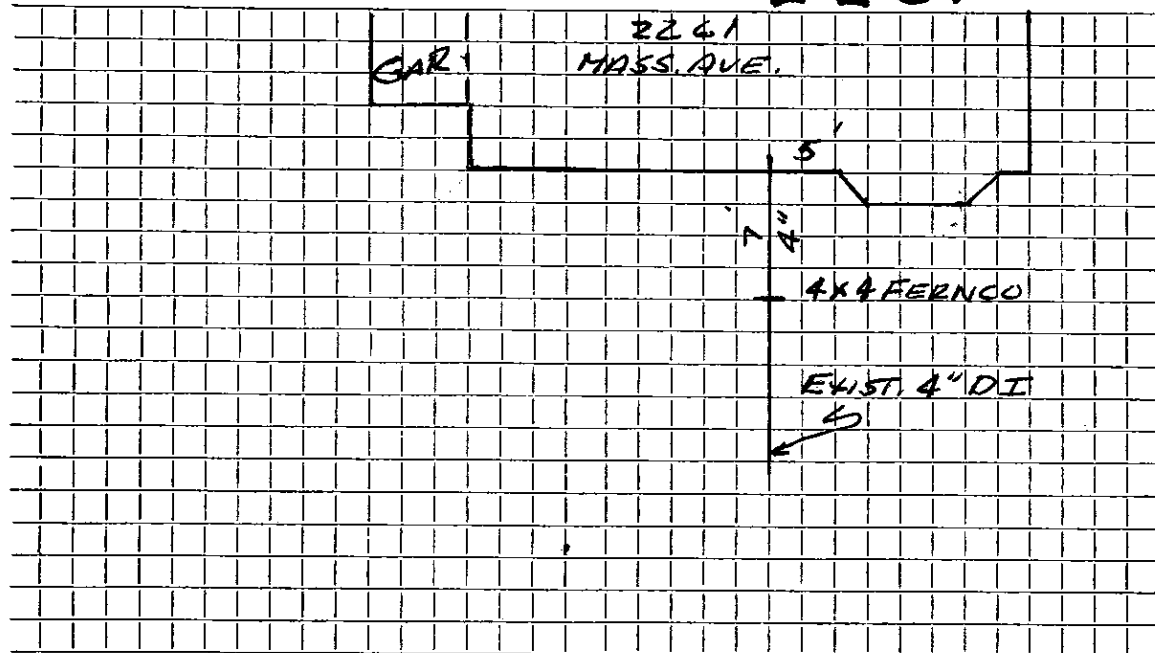

Connection made in MASS. AVE. Street. Work completed

Remarks: USED EXIST. SERV. Original Service 8-13-73

.....
.....