




DATE 7/17/19

TOWN OF LEXINGTON — BOARD OF PUBLIC WORKS  
SEWER DIVISION

Sketch of Service Here

Sewer service for 2295 Mass Ave →

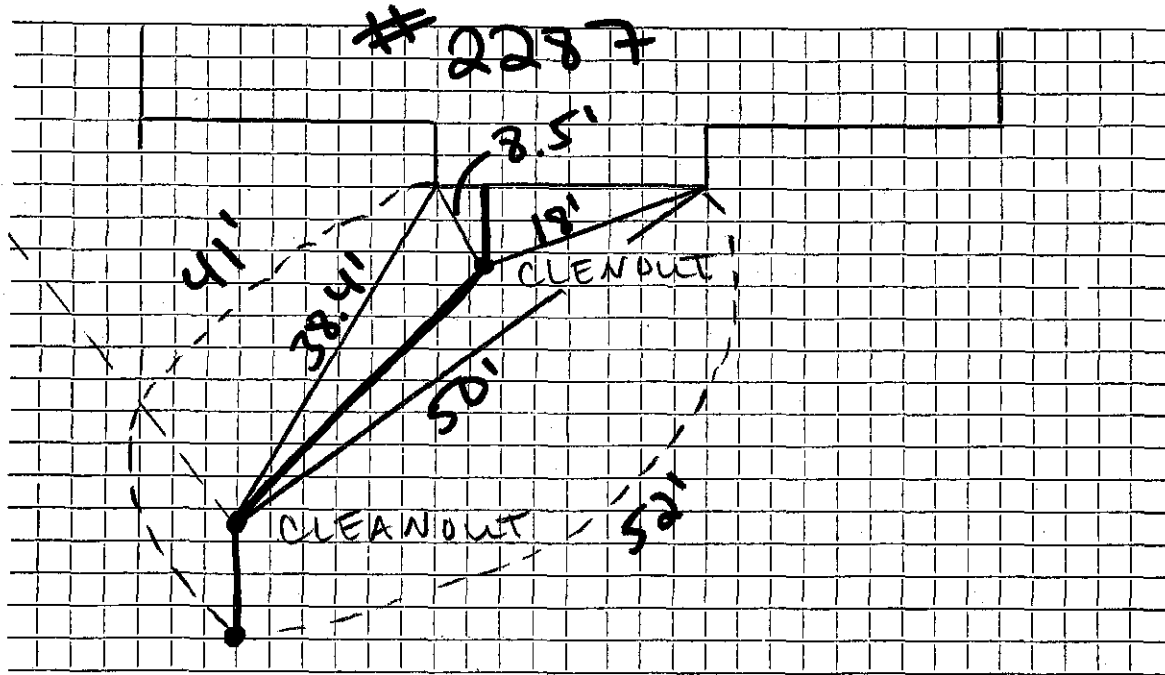

Connection made in ... Mass Ave ... Street. Work completed .....

Remarks: .....  
.....  
.....