

Name

SERVICE NO.

Address 2295 Mass Ave

2295 Mass. Ave.

Location 2295 Mass. Ave

Kind of Pipe

Size

Size of Main

Repair—Renewal—New Service

Location

Date	Material	Amount		Total		Date				Amount
1932	Labor									

Hadley Press, Inc., Lexington

TOWN OF LEXINGTON—BOARD OF PUBLIC WORKS

SEWER DIVISION

DATE October 5, 1933

NO. \_\_\_\_\_


The undersigned applies for the construction of a particular sewer connecting No. 2295 Mass. Ave. Street and hereby agrees to comply with the Rules and Regulations governing the construction and use of Particular Sewers, as now or at any future time established by the Board of Selectmen.

Am't. of Estimate \$ \_\_\_\_\_

Am't. Paid \$ \_\_\_\_\_

Roy Johnson Owner

Sketch of Service Here

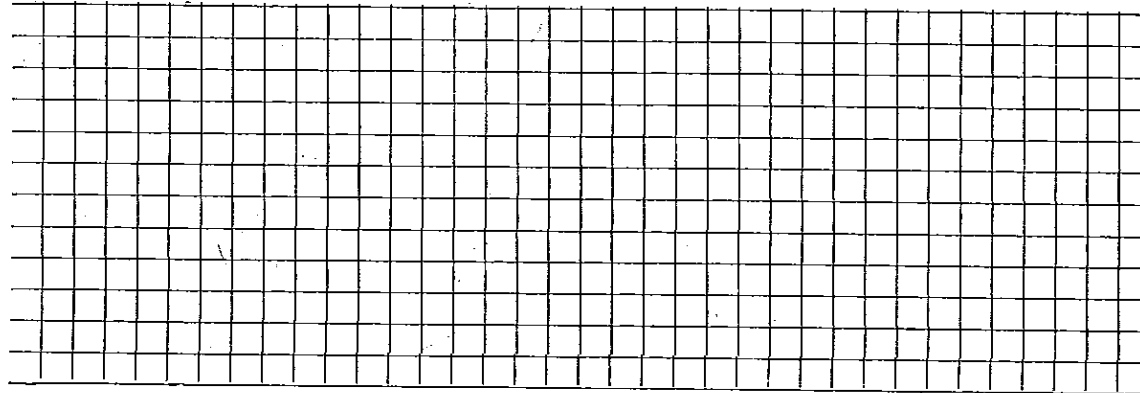

Connection made in \_\_\_\_\_ Street.

Work completed \_\_\_\_\_ 19

Remarks: