

Name Community Nursery School

Service No. 100

Address 2325 Mass. Avenue

2325 Mass. Ave.

Location

Kind of Pipe

Size 6"

Size of Main 8"

Repair—Renewal—New Service Tribino #1750

Location DEC 31 1970

Date	Material	Amount	Total	Date	Amount
<del>Nov 170</del>	<del>36' 6" Transite pipe @7.50</del>		<del>270.00</del>	<del>10-8-70</del>	<del>Deposit</del>
10/15/70	229' 6" Transite pipe				
	16' 4" Cast Iron pipe			11- - 70	
				36' 6" Transite	
				1 6" X 8" Wye	
AUG 99	Jim MCLAUGHLIN REPAIR				
	30' 6" PVC				
	2 6" PVC X AC FEMALE				
		3-24-99	PAPER+solids	1-5-99	SD-PAPERS
				1-29-99	Roots
				5-7-93	Roots + PAPERS
				12-10-96	PAPERS 42' from clean out
				2-4-99	PAPER+solids 21+45' from clean out


TOWN OF LEXINGTON — BOARD OF PUBLIC WORKS

SEWER DIVISION

#2325

2325

Sketch of Service Here

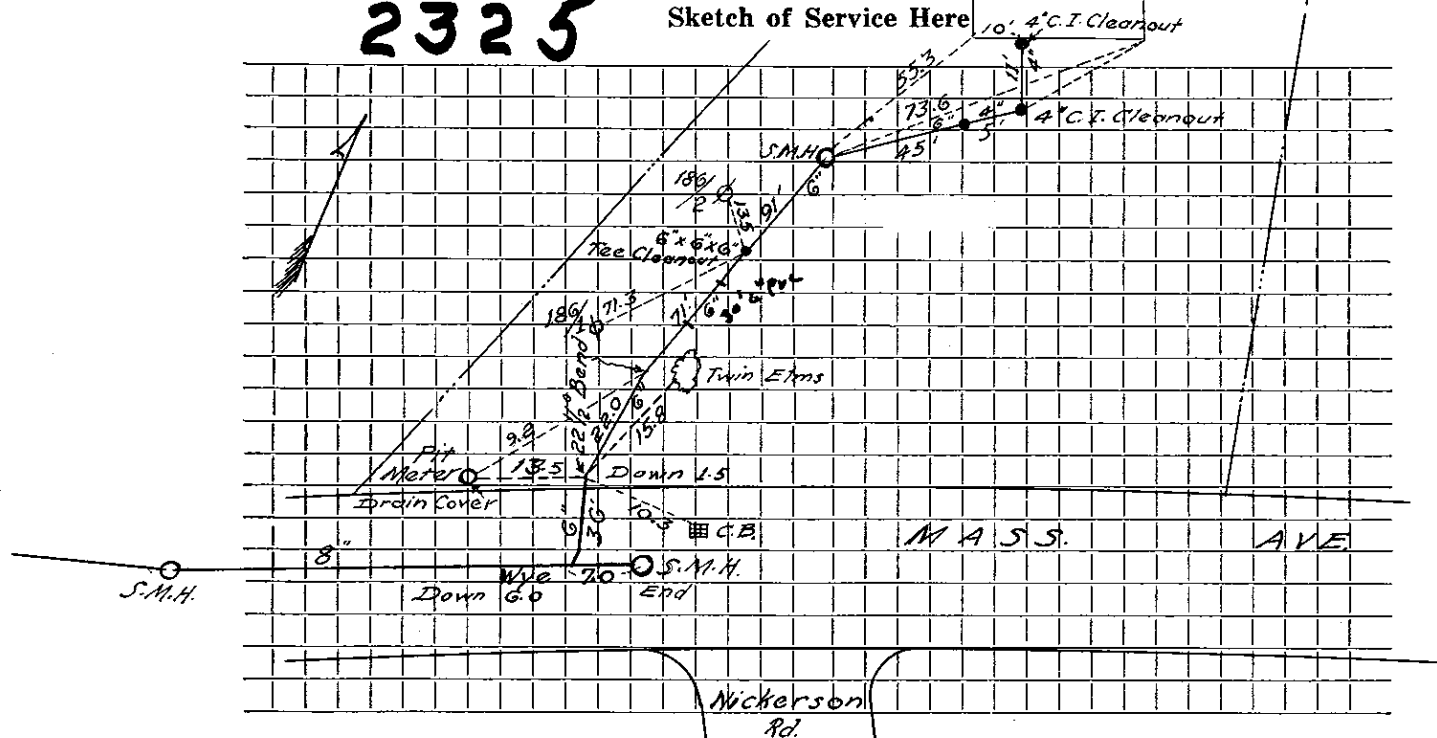

Connection made in ..... Street. Work completed .....

Remarks: AUG. 99. REPAIR 30' PUC 17' FROM TEE CLEAN OUT TOWARD S.T.

.....  
.....