

Name William E. Maloney

Service No. 57

Address 350 Mass. Avenue

Location

*Crown 10-14-58*

Kind of Pipe

Size

Size of Main

~~REPAIR SERVICE~~ New Service

Location

Date	Material	Amount	Total	Date	Amount
-23-58	Labor	61.56			100.00
	10 % O.H.	6.16	67.72	11-14-58	2.54
25'	6" Transite Pipe @ .70		17.50	"	2.87
1	6" Transite Elbow		5.29	11-13-58	6.22
6	3/4 Ton 1 1/4" Stone @ 1.50 ton		10.13		111.89
1 1/2	hr. Town Shovel @ 6.50		9.75		
2	hrs. Trucking @ .75		1.50		
			111.89		
	Labor				

TOWN OF LEXINGTON—DEPT. OF PUBLIC WORKS  
SEWER DIVISION

DATE.....

NO. ....


The undersigned applies for the construction of a particular sewer connecting No.....  
Street and hereby agrees to comply with the Rules and Regulations governing the construction and use of Particular  
Sewers, as now or at any future time established by the Board of Selectmen.

Am't of estimate \$.....

Am't Paid \$.....

..... Owner

Sketch of Service Here **350**

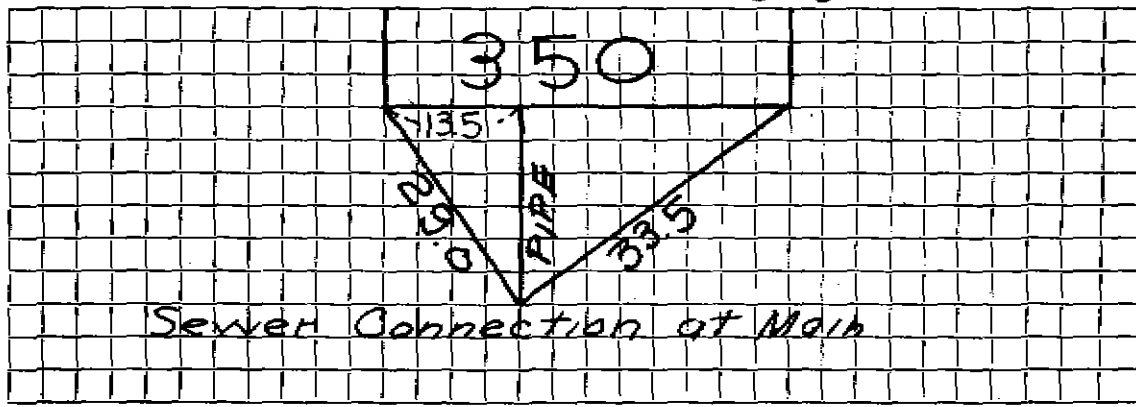

Connection made in..... Street.

Work completed.....19..

Remarks: