

Name Ragnild S. Garfield

Service No. 23 462

Address 368 Mass. Avenue, Lexington,

Location same

Kind of Pipe

Size

Size of Main

~~Repair~~ New Service

Location

Date	Material	Amount	Total	Date	Amount
1938					
Oct. 26	11 hrs @ 50¢	5 50		October 21, 1938	75 00
<i>Com 11-21-38</i>	42½ " @ 55	23 38		Nov. 25, 1938	12 59
	16 " @ 60	9 60	38 48		56 41
	10% Overhead		3 85		
	38' 6" Sewer Pipe @ 20¢		7 60		
	3 6" 1/8 Bends @ 65¢		1 95		
	Joint Compound		2 28		
	3 hrs. trucking @ 75¢		2 25		
			56 41		
	Labor			9-25-91	Joer Problem

Hadley Press, Inc., Lexington.

TOWN OF LEXINGTON—BOARD OF PUBLIC WORKS

SEWER DIVISION

DATE 10-20-38

NO. 368 Miss Aue


The undersigned applies for the construction of a particular sewer connecting No. 368 Street and hereby agrees to comply with the Rules and Regulations governing the construction and use of Particular Sewers, as now or at any future time established by the Board of Selectmen.

Am't. of Estimate \$ 75.60

Am't. Paid \$ 75.60

Ragnhild S. Garfield Owner

Sketch of Service Here

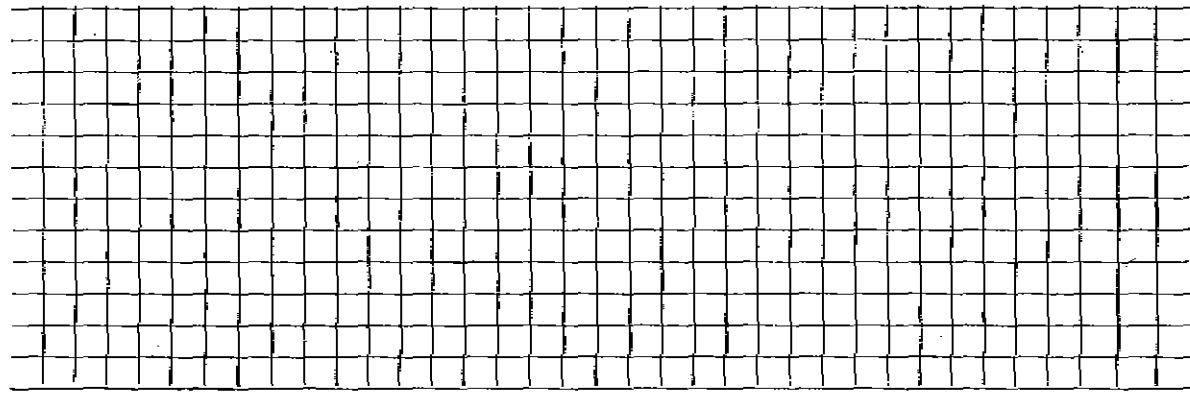

Connection made in _____ Street. Work completed _____ 19

Remarks: