


SEWER DIVISION

Sketch of Service Here

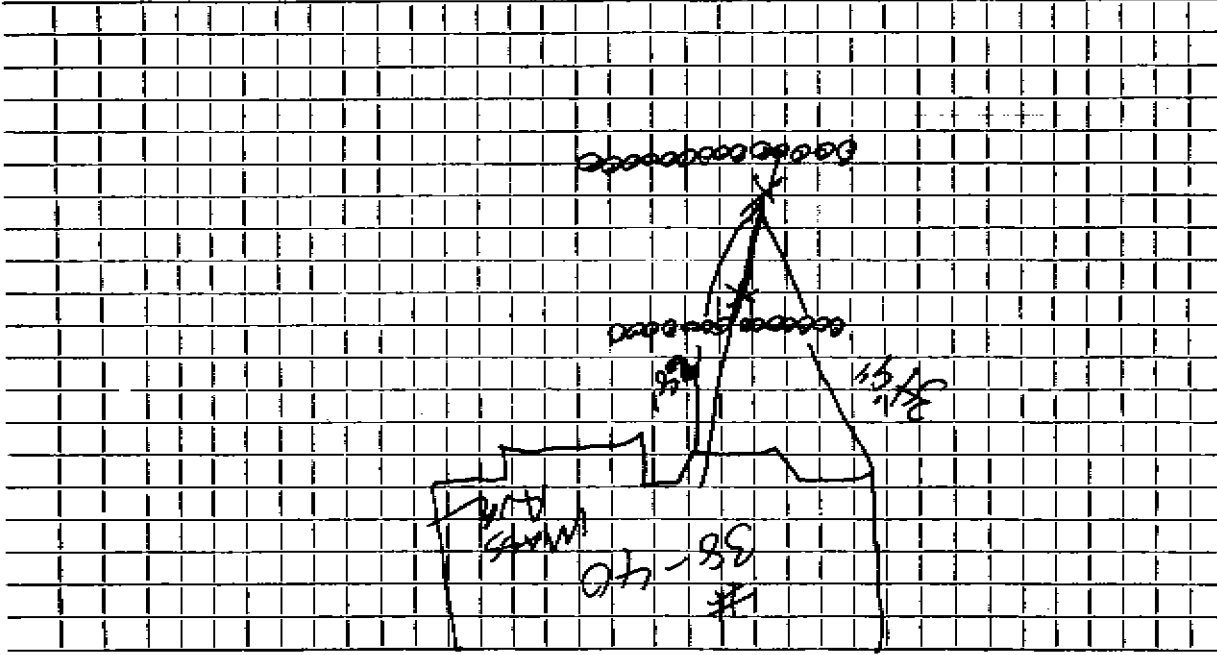

Connection made in _____ Street. Work completed _____

Remarks: _____