

Name **Gray Construction Corp.**

Service No. **#13**

Address **400 Mass. Avenue**

Location

Kind of Pipe

Size

Size of Main

~~Repair~~ ~~Renewal~~ ~~XXXX~~ **New Service** **WD #7082**

Location **Corner 25-62**

Date	Material	Amount	Total	Date	Amount
4-10-62	Labor	17.91		3-23-62	300.00
4-11-62	"	40.85	58.76	6-25-62	179.47
	10% O.H.	5.88	64.64		120.56
	39' 6" Transite Pipe @78		30.42		
	3 Hrs. Town Shovel @6.50		19.50		
	2 Hrs. Trucking @3.00		6.00		
			120.56		
	Labor				

TOWN OF LEXINGTON—DEPT. OF PUBLIC WORKS
SEWER DIVISION

DATE.....

NO.


The undersigned applies for the construction of a particular sewer connecting No.....
Street and hereby agrees to comply with the Rules and Regulations governing the construction and use of Particular
Sewers, as now or at any future time established by the Board of Selectmen.

Am't of estimate \$.....

Am't Paid \$.....

..... Owner

Sketch of Service Here

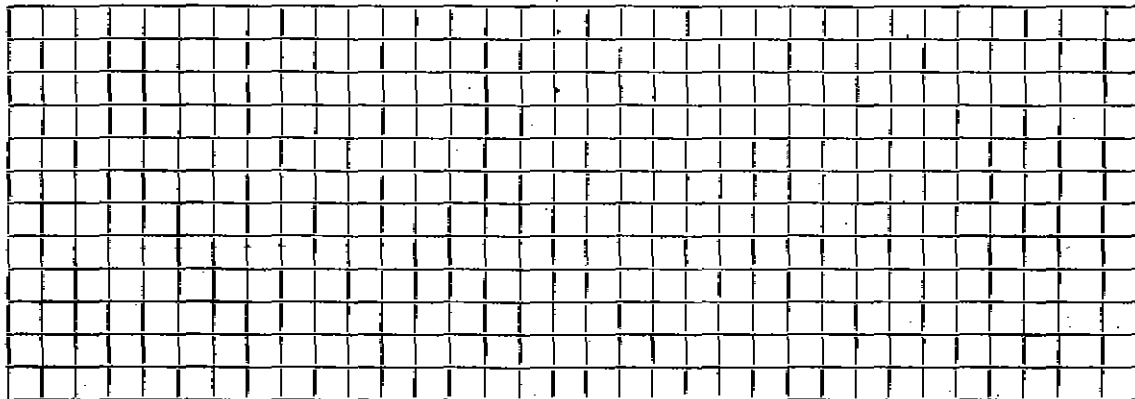

Connection made in..... Street.

Work completed..... 19..

Remarks: