

Name

Service No.

Address 410 Mass Ave

Location

Kind of Pipe

Size

Size of Main

Repair—Renewal—New Service

Location

Date	Material	Amount	Total	Date	Location	Amount
5-29-30						
35'	6" Sewer Pipe				Outside;	
1	6" X Wye					
1	6" - 1/8" Bend			3-23-95	10'-6" PUC	
1	6" ELL				1-6" CL-PUC Ferreo "	
					1-6" PUC-PVC "	
					1-8x6 CL-PUC "	
					1- 22° Bend.	


12-57 94 No. 35

DATE 3-24-95

TOWN OF LEXINGTON — BOARD OF PUBLIC WORKS
SEWER DIVISION

Sketch of Service Here

410

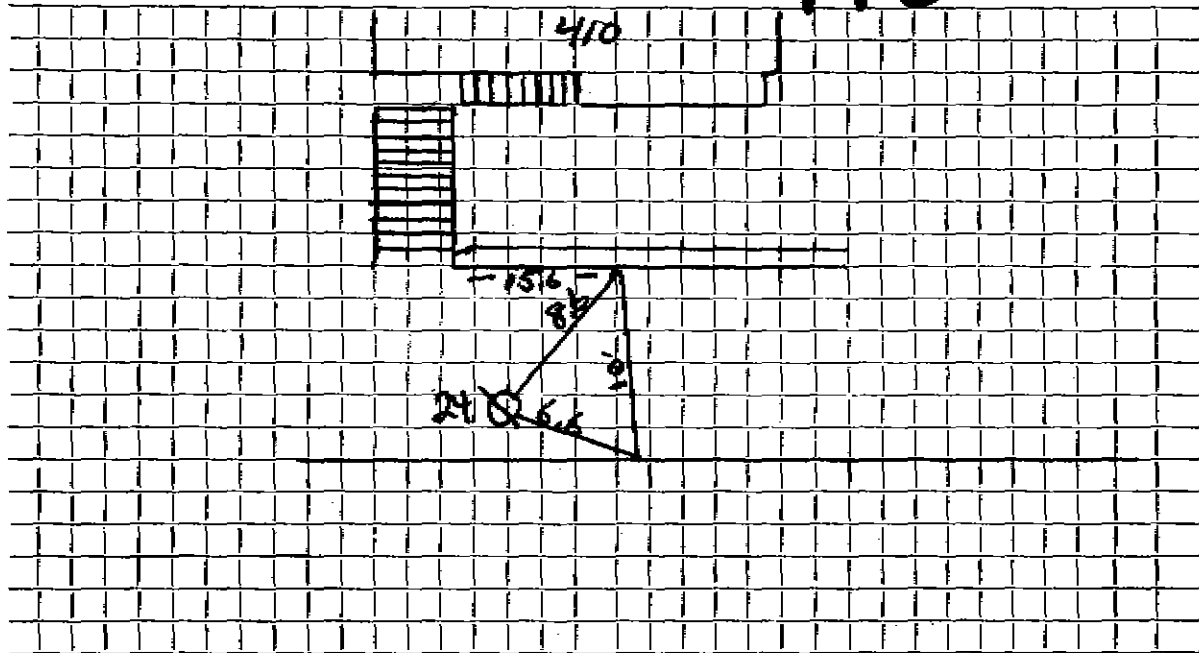

Connection made in Street.

Work completed 3-23-95

Remarks: ... Sewer... 1' under... Water... Service... Made Connection... 1' under...
Wall... Sewer Main... 1' outside Curb Stone... 5' deep at Wall...