

Name Edward J. O'Brien

Service No. 126

Address 420 Mass. Avenue

Location

Kind of Pipe

Size

Size of Main

~~REPAIR~~—Renewal—~~RECESS~~ W.O. #8220

Location Comm 2-10-64


Date	Material	Amount	Total	Date	Amount
0-3-63	Labor 112.84			11-2-63	Deposit 200.00
0-4-63	" 48.14	160.98			
	10% O.H.	16.10	177.08		
24'	6" Transite pipe @.82		19.68		
1	4' Bend		2.62		
2	22½° Transite bend @4.09		8.18		
1	11¼° Transite Bend		4.09		
1	6" Duplex Adapter		1.62		
1	6 x 6 Y		4.09		
1	6 x 12 Nipple		.91		
2	yard loam @3.00		6.00		
1	hr. Town Shovel @6.50		6.50		
3	hrs. Trucking @3.00		9.00		
1	hr. Loader @5.00		5.00		
	7 x 3 Patch		7.00		
	(33 yrs. old. Too old to prorate)		251.77		Bill sent 5/22

DATE \_\_\_\_\_

TOWN OF LEXINGTON — BOARD OF PUBLIC WORKS

SEWER DIVISION

Sketch of Service Here **420**

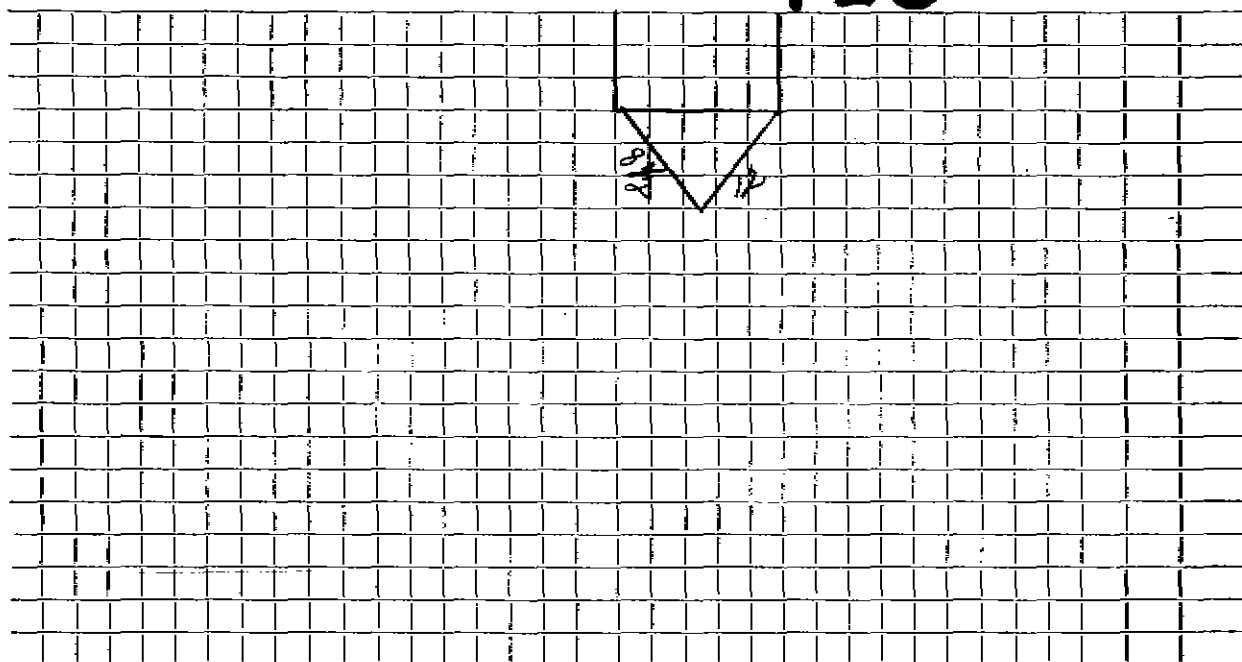

Connection made in ..... Street ..... Work completed .....

Remarks: *Original Service 5-28-30 (32'-6" Sewer Pipe, 5' 4" Iron, 2-1/4" Bends, 1-1/8" Bend.)*