

Name

Service No.

Address 140 Mass. Ave.

Location

Size of Main

Size

Repair - ~~Reinforcing~~ ~~Sheet Piling~~

Location

Date	Material	Amount	Total	Date	Amount
-26-28					
98'	6" Clay Pipe				
2	6" Tees				
3	6" Wyes				
1	6" X 4" Reducer			12-24-51	58 42
2	6" X 1/8" Bends			8'-6" Sewer Pipe @.342	2 73
5	4" Wye			Joint Compound	48
1	4" Wye			2 Hr. Trucking @.45	1 50
1	Cleanout			Total	61 13
	Labor				

TOWN OF LEXINGTON—DEPT. OF PUBLIC WORKS

SEWER DIVISION

DATE

NO.


The undersigned applies for the construction of a particular sewer connecting No.
Street and hereby agrees to comply with the Rules and Regulations governing the construction and use of Particular
Sewers, as now or at any future time established by the Board of Selectmen.

Am't of estimate \$.....

Am't Paid \$.....

..... Owner

Sketch of Service Here

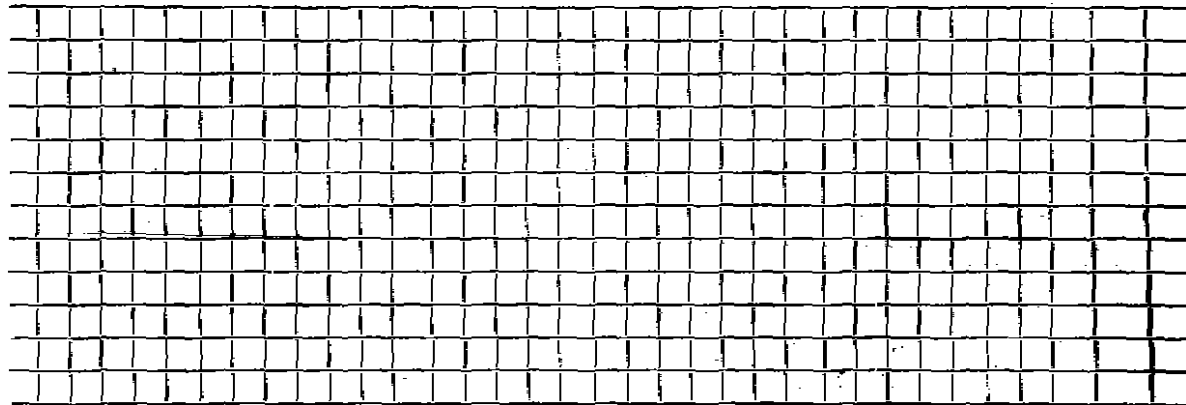

Connection made in Street.

Work completed 19...

Remarks: