


DATE 1 / 5 / 23

TOWN OF LEXINGTON — BOARD OF PUBLIC WORKS

SEWER DIVISION

Sketch of Service Here

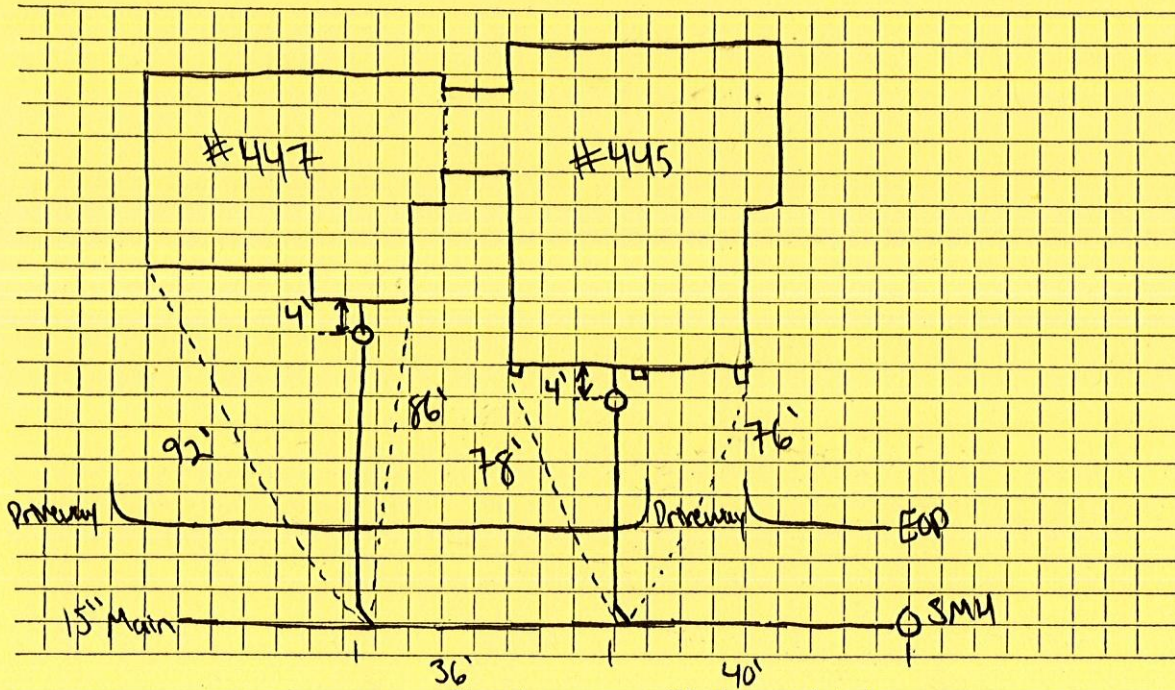

Connection made in Street. Work completed

Remarks: ..INSTALLED By ..CJ DOHERTY.....