




DATE 12/4/90

TOWN OF LEXINGTON — BOARD OF PUBLIC WORKS  
SEWER DIVISION

Sketch of Service Here **480**

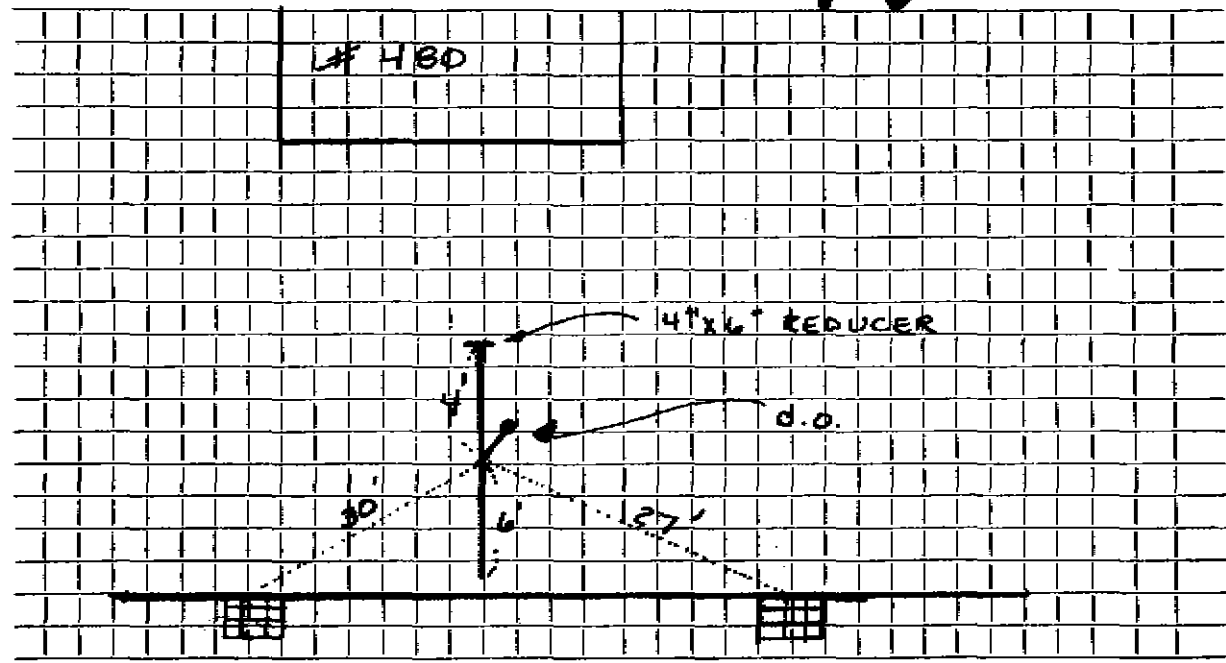

Connection made in ... MASS ... AVE Street. Work completed .....

Remarks: Original Service 3-23-55 (110'-6" Sewer Pipe) .....