

Name ~~Porter~~ Realty Trust

Service No. 29

Address ~~125~~ Mass. Avenue

Location

Kind of Pipe

Size

Size of Main

~~REPAIR~~ New Service

Nicholas Bonanno Permit #237 W.O.#82

Location

MAR 14 1966

Date	Material	Amount	Total	Date	Amount
1-65	Labor 116.64			4-13-65	350.00
3-65	" 107.74	22 38		4-8-66	120.61
	10% O.H.	22 14	246.82		470.61
50'	6" Transite Pipe @.82		41.00		9.41
1	6" 90° El.		4.09		
1	12" X 6" Iron Saddle		5.75		Non CHARGE
	7" X 7' Patch Sidewalk		16.33		Surcharge of Concrete
2	Hrs. Shovel @6.50		13.00		
6	Hrs. Town Truck @300		18.00		
1	Hr. Loader		4.00		
5	Yds. Concrete @1.50	317.25	7.50	88.75	
	24' X 11' Reinforce wire		6.45		
50	Yards Gravel @1.50		75.00		
			470.61		


All sent 1224

DATE \_\_\_\_\_

TOWN OF LEXINGTON — BOARD OF PUBLIC WORKS

SEWER DIVISION

Sketch of Service Here

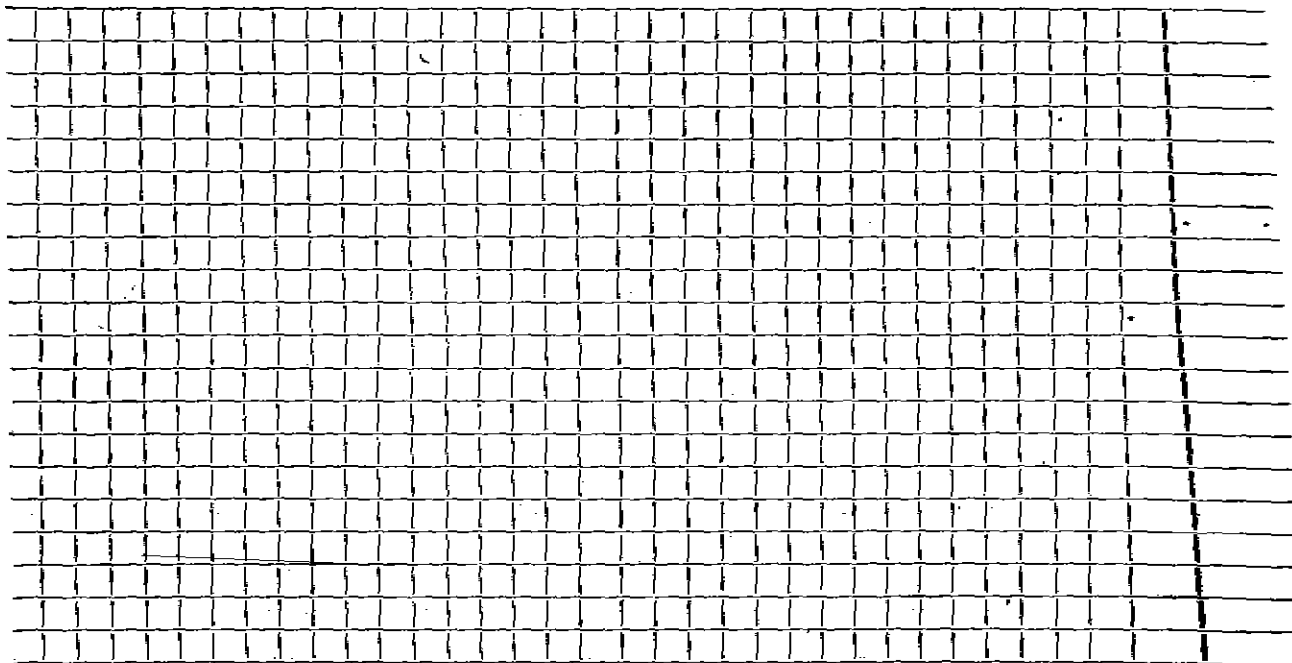

Connection made in ..... Street. Work completed .....

Remarks: *Original Service 7-29-30 (80'-6" Sewer Pipe)* .....

.....  
.....