

Warren E. Halley

Service No. 87 496

Address 488⁵⁰² Mass. Ave.

488 + 502 Mass. Ave. Location 488 + 502 Mass. Ave

Kind of Pipe

Size

Size of Main

Repair—Renewal—New Service

Location

Date 1937	Material	Amount	Total	Date	Amount
Oct. 21	15 hrs. @ 50¢	7 50		Oct 14. 1937 Deposited	105 00
10-26-37	18 1/2 " @ 55¢	10 18		Oct 30. 1937 Refunded -	47 25
	18 1/2 " @ 60¢	11 10			57 25
	3 " @ 65	1 95	30 73 ✓		
	10% Overhead		3 07 ✓		
	20' 6" Sewer Pipe @ 20¢		4 00 ✓		
	1 1/8 6" Bend		1 00		
	Jointing compound		1 20 ✓		
	3 hrs. trucking @ 75¢		2 25 ✓		
	Trench Repairs - 5 sq. yds @ 3.00		15 00		
	50' 6" Sewer Pipe		\$57 25		
	Labor				

Egglew Properties, Inc., Lexington

TOWN OF LEXINGTON—BOARD OF PUBLIC WORKS

SEWER DIVISION

DATE Oct 13 1937

NO. 488 + 502


The undersigned applies for the construction of a particular sewer connecting No. 488 + 502 Main Ave Street and hereby agrees to comply with the Rules and Regulations governing the construction and use of Particular Sewers, as now or at any future time established by the Board of Selectmen.

Am't. of Estimate \$ _____

Am't. Paid \$ _____

Warrick G. G. G. G. G. Owner

Owner to dig trench.

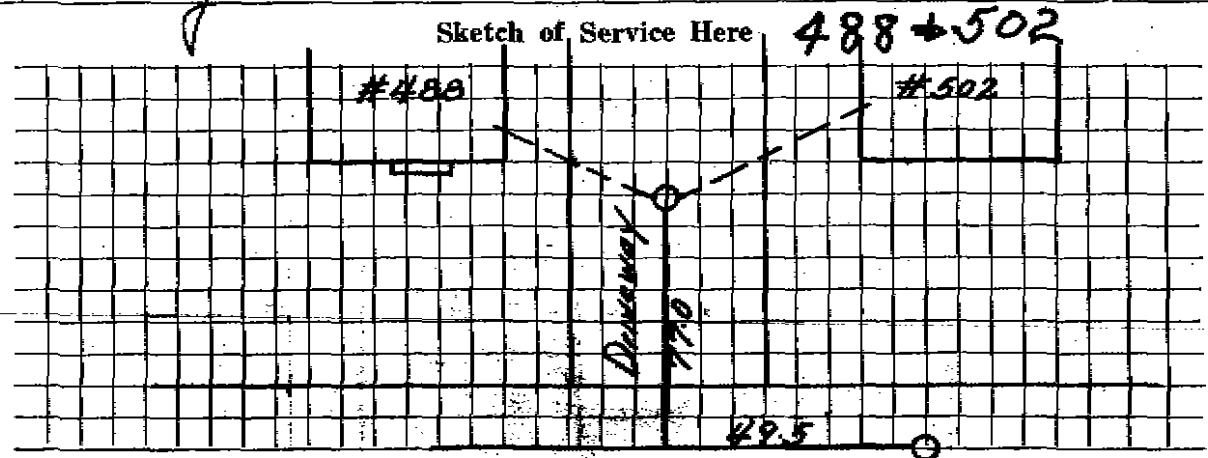

Connection made in _____ Street. Work completed _____ 19

Remarks: