

Name **Glen Realty Trust**

Service No. **131**

Address **50 Mass. Avenue**

Location

Kind of Pipe

Size

Size of Main

~~Water Main~~ **New Service W.O. #8235**

Location **MAR 23 1964**


Date	Material	Amount	Total	Date	Amount
-16-63	Labor	122 45		10-11-63	Deposit 400 00
	10% O.H.	12 25	134 70	3-23-64	Retard 192 30
18	4" C.I. Water Pipe @1.75		31 50		207 70
3	Hrs. Town Shovel @6.50		19 50		
2	Hrs. Trucking @3.00		6 00		
1	Hr. Compressor @5.00		5 00	9-20-06	Main blocked
11	X 3 Patch		11 00		26' up from M.H. on Mass Ave
			207 70		

DATE _____

TOWN OF LEXINGTON — BOARD OF PUBLIC WORKS

SEWER DIVISION

Sketch of Service Here **50**

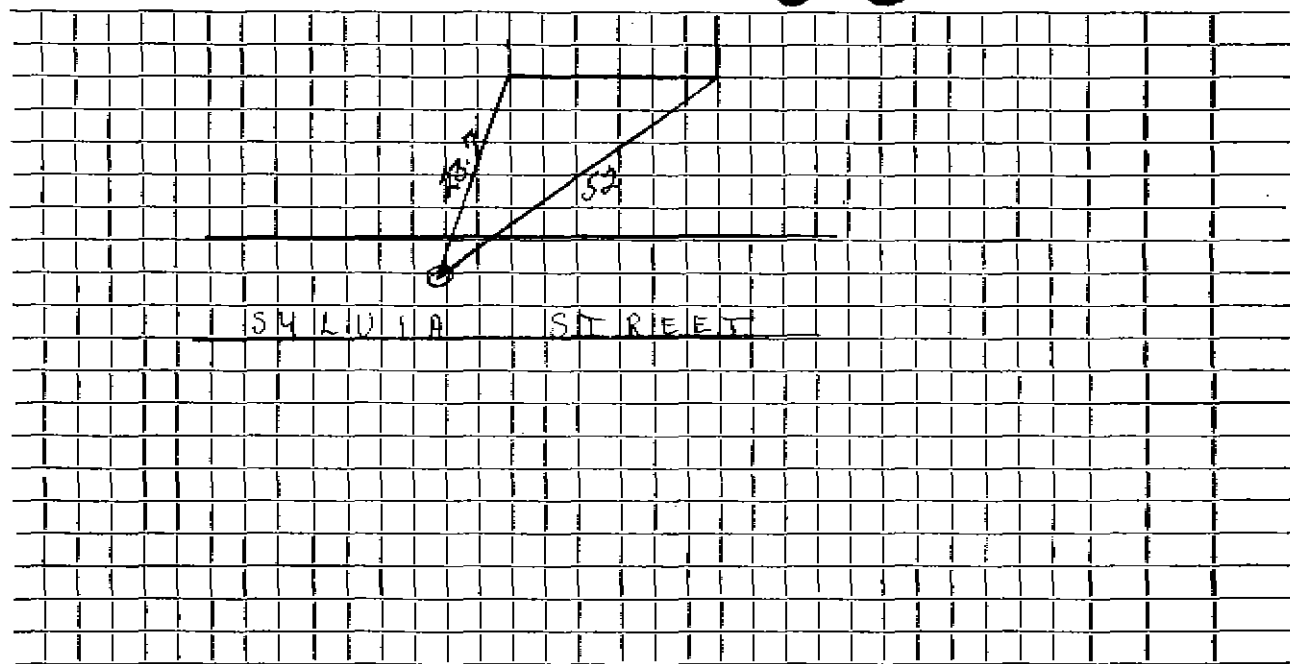

Connection made in Street. Work completed

Remarks:
.....
.....