

Service No. 491

516 Mass. Ave.

516 Mass. Ave.

Size of Main

Size

Kind of Pipe

New Service

Location

Date	Material	Amount	Total	Date	Amount
Received	50' of 12" Pipe @ .30	15 00			
6/1/25	1 2" x 1/2" Band	70		May 24 1925 - Cash	65 05
	1 8" Y	1 05			
	Trucking	75			
	Sulphur & Jute	8 00	19 50		
4/20/28	6 1/2 hrs. Labor @ .55	35 32			
	6 " " @ .55	3 90	42 22		
	15% overhead		6 23	68 05	
	Labor				

TOWN OF LEXINGTON—BOARD OF PUBLIC WORKS

SEWER DIVISION

DATE _____

NO. _____


The undersigned applies for the construction of a particular sewer connecting No. _____ Street and hereby agrees to comply with the Rules and Regulations governing the construction and use of Particular Sewers, as now or at any future time established by the Board of Selectmen.

Am't. of Estimate \$ _____

Am't. Paid \$ _____

Owner

Sketch of Service Here

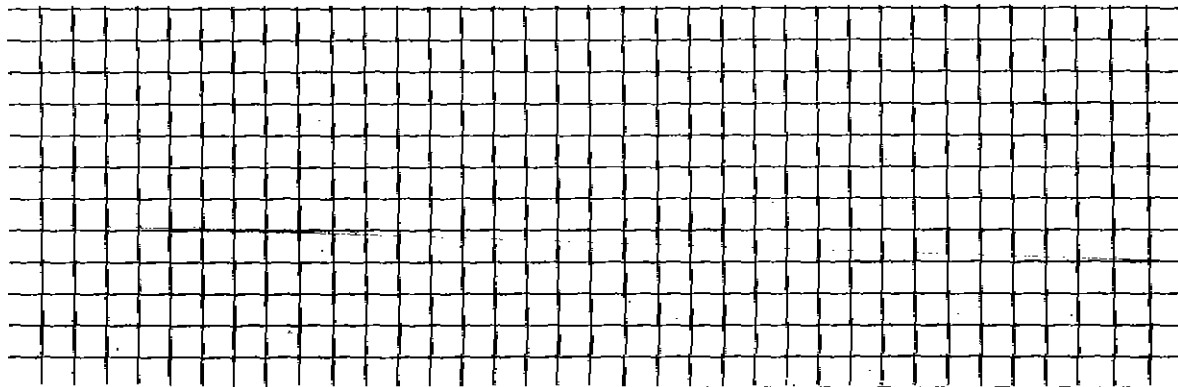

Connection made in _____ Street.

Work completed _____ 19

Remarks: