

Name **Martin J. Carrigan**

Service No. **50 480**

Address **529/531 Mass Ave.**

529 (Right Unit) and 531 (Left Unit)
per Engr. Dept. 5/6/86

~~529 Mass. Ave.~~

Location **531 Mass. Ave.**

Kind of Pipe

Size

Size of Main

~~Remove~~ - New Service

Location

Date	Material	Amount	Total	Date	Amount
09-24-29	56' 6" Sewer Pipe @ .30	16 80			
for 19.79	Sulphur & Jute	2 24			
	Trucking	75	19 79	Oct. 23 1929 - Cash	19 79
9/20/	Labor on water bill				
	Labor				

Hidley Press, Inc., Lexington

TOWN OF LEXINGTON—BOARD OF PUBLIC WORKS

SEWER DIVISION

DATE _____

NO. _____


The undersigned applies for the construction of a particular sewer connecting No. _____ Street and hereby agrees to comply with the Rules and Regulations governing the construction and use of Particular Sewers, as now or at any future time established by the Board of Selectmen.

Am't. of Estimate \$ _____

Am't. Paid \$ _____

_____ Owner

Sketch of Service Here

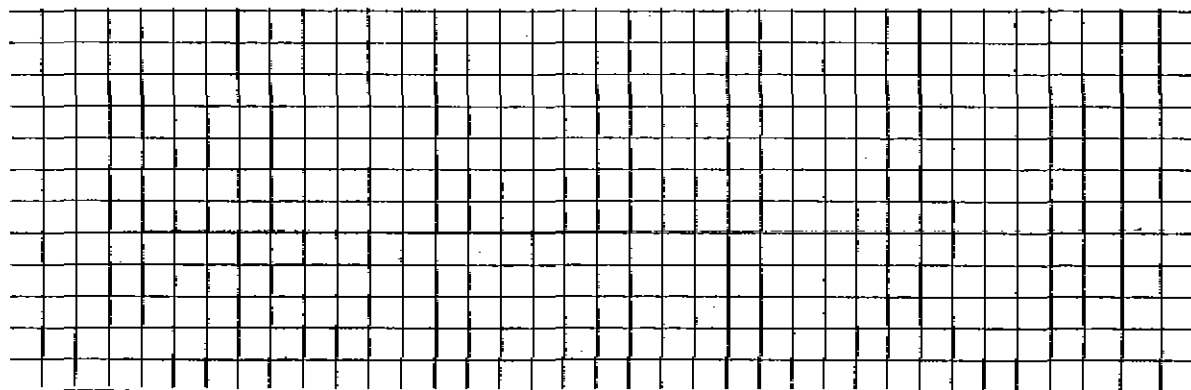

Connection made in _____ Street.

Work completed _____ 19 _____

Remarks: