

Address ~~26 Boston St., Roxbury~~

56 Mass Ave.

36 Mass. Ave.

Location Store cor. Sylvia St. & Mass. Ave.,
(in from Sylvia St.)

Kind of Pipe

Size

Size of Main

Repair—Renewal—New Service

Location

Date	Material	Amount	Total	Date	Amount
June 1, 1939	8 hrs. @ 50¢	4 00		May 23, 1939	50.00
June 6, 1939	4 1/2 " @ 55¢	2 48			
	20 " @ 60¢	12 00	18 48		
	10% Overhead		1 85		
	16' 6" Sewer Pipe @ 20¢		3 20		
	Joint Compound		96		
	2 1/2 hrs. Compressor @ 3.00		7 50		
	1/4 bag cement		20		
	2 hrs. trucking @ 75¢		1 50		
	Trench repairs		12 00		
			45 69		
	Flat Rate: \$50.00				
	Labor				

Essex Press, Inc., Lexington

TOWN OF LEXINGTON—BOARD OF PUBLIC WORKS

SEWER DIVISION

DATE May 25, 1939

NO. _____

The undersigned applies for the construction of a particular sewer connecting No. 56 Mass Ave Street and hereby agrees to comply with the Rules and Regulations governing the construction and use of Particular Sewers, as now or at any future time established by the Board of Selectmen.

Am't. of Estimate \$ 50⁰⁰


Am't. Paid \$ 50⁰⁰

*no Section
Rockbury*

Ed Lesser Owner
by Harry Lesser

*Address not notify
when ready*

Sketch of Service Here **56**

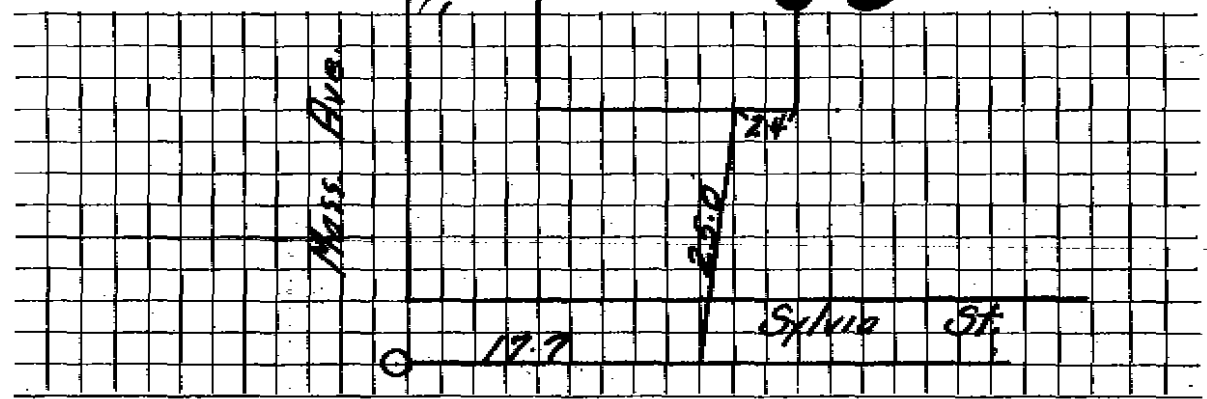

Connection made in _____ Street. Work completed _____ 19

Remarks: