


DATE 8/1/90

TOWN OF LEXINGTON — BOARD OF PUBLIC WORKS P.A.B.

SEWER DIVISION

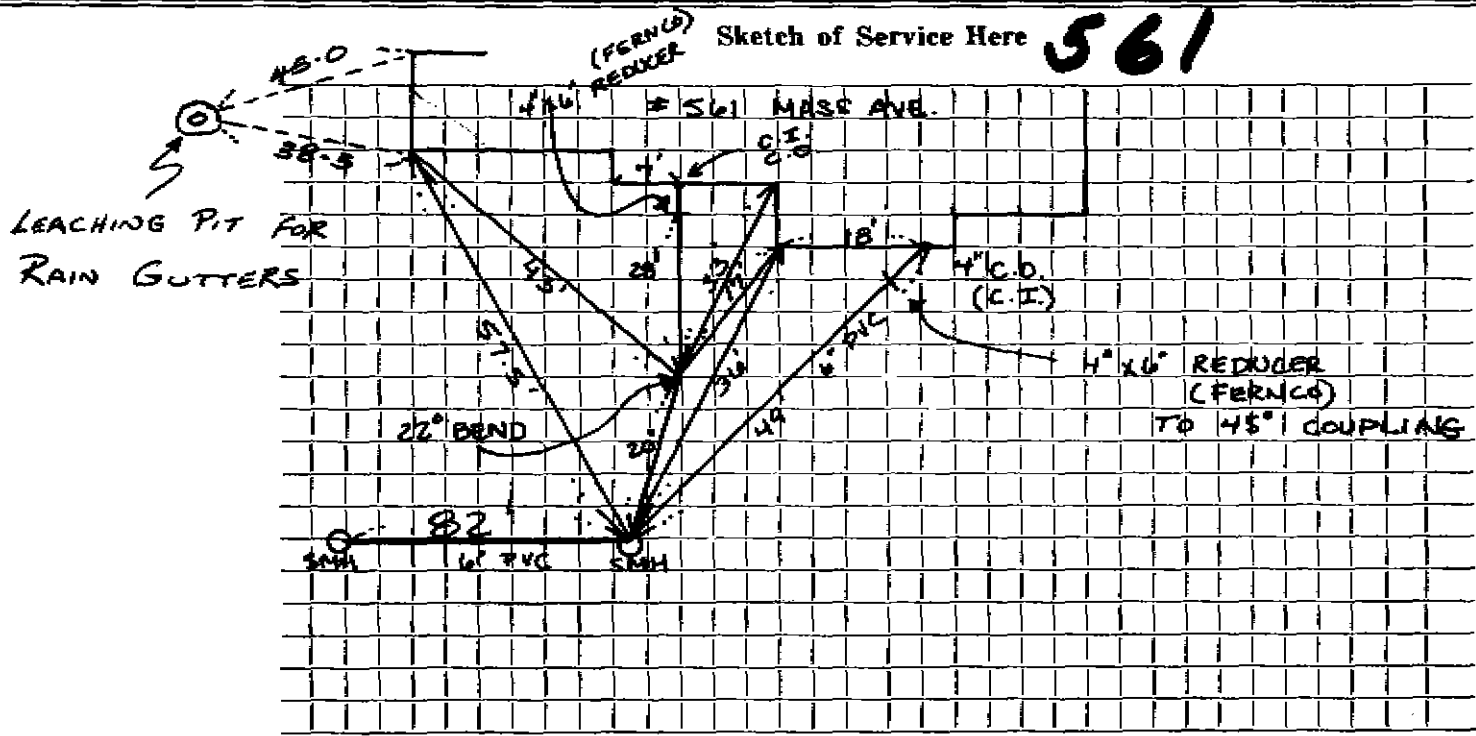

Connection made in MASS AVE. Street. Work completed

Remarks: INSPECTED: P.A. BARRONS Original Service 9-18-28 (84'-6" Sewer Pipe
 CONTRACTOR: SMITH-GROVE 10'-4" Iron Pipe, 1-6" Band, 1-6" x 4" Reducer)