

Name Workingmens Co-op. Bank

Service No. 8 485

Address ~~75 Cornhill, Boston, Mass.~~

618-620 Mass Ave

Location 618-620 Mass. Ave.,

Kind of Pipe

Size

Size of Main

~~Repairs-Repentak~~ - New Service

Location

Date 1941	Material	Amount	Total	Date	Amount
June 4,	55 hrs. @ 50¢	27 50		<i>May 13, 1941 Deposited</i>	150 00
<i>Sum. 4/30/41</i>	21 hrs. @ 55¢	11 55			
	48 hrs. @ 60¢	28 80		<i>July 10, 1941 Paid</i>	165 19
	48 hrs. @ 65¢	31 20	99 05		
	10% Overhead		9 90		
	72' 6" Sewer Pipe @ 16¢		11 52		
	5' Iron Pipe @ 50¢		2 50		
	1 6" 1/4 Bend		65		
	1/2 bag cement @ 75¢		38		
	Jointing compound		4 32		
	Compressor 3 1/2 hrs. @ 2.25		8 88		
	Trucking - 4 hrs. @ 75¢		3 00		
	Trench repairs		24 99		
	Labor		165 19	<i>13th sent 7/2/41</i>	

Hadley Press, Inc., Lexington

TOWN OF LEXINGTON—BOARD OF PUBLIC WORKS
SEWER DIVISION

DATE _____

NO. _____


The undersigned applies for the construction of a particular sewer connecting No. _____
Street and hereby agrees to comply with the Rules and Regulations governing the construction and use of Particular
Sewers, as now or at any future time established by the Board of Selectmen.

Am't. of Estimate \$ _____

Am't. Paid \$ _____

Owner _____

Sketch of Service Here **618-620**

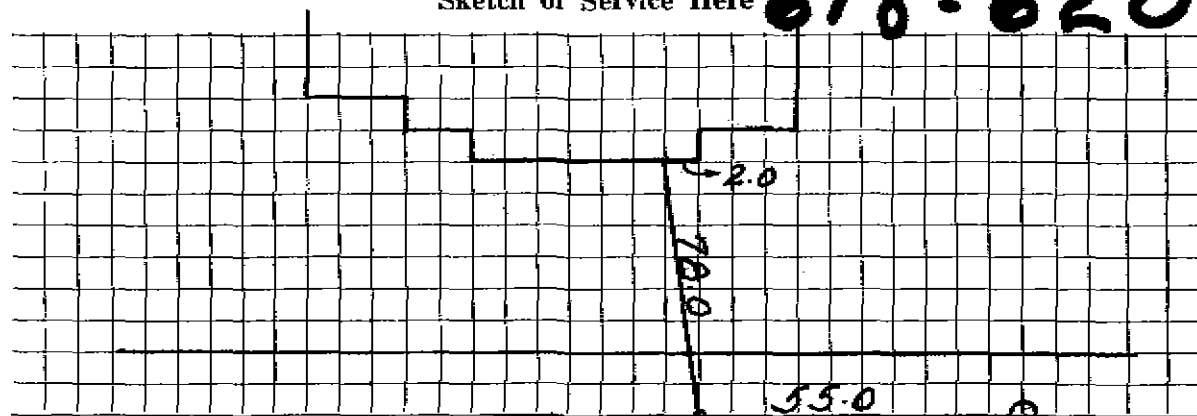

Connection made in _____ Street.

Work completed _____ 19

Remarks: