




DATE 7/12/95

TOWN OF LEXINGTON — BOARD OF PUBLIC WORKS  
SEWER DIVISION

Sketch of Service Here

627

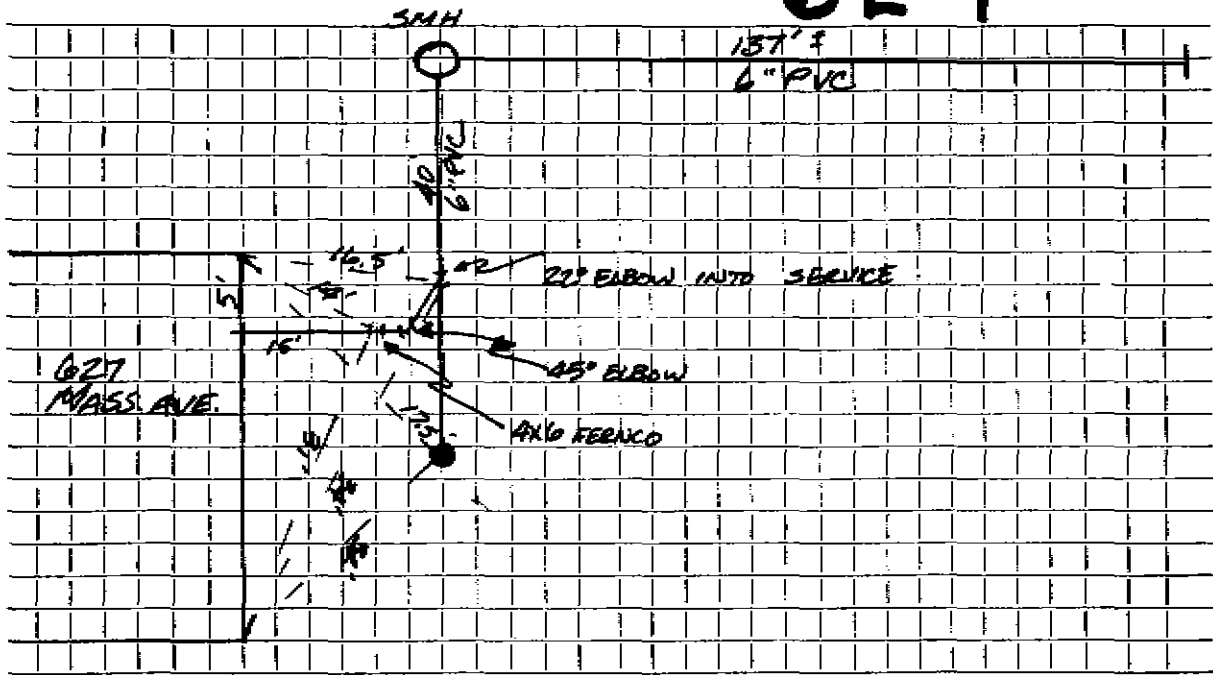

Connection made in ..... MASS. AVE. Street. Work completed ..... M. C. LAVERGNE .....

Remarks: .....  
.....  
.....