

Name Wilson Farms Inc.

Service No. 59

Address 632 Massachusetts Avenue

Location

Kind of Pipe

Size

Size of Main

Repair ~~Renewal~~ New Service

W. O. # 9636

Location JUL 31 1972


Date	Material	Amount	Total	Date	Amount
5/10/72	Labor	182 31		5-3-72	Deposit 430 00
5/19/72	Police Labor	40 00 39 30		7-31-72	Paid by WITC#20 26 96
	10% O.H.	26 16	287 77	11-3-72	Balance 15 96
	35' 6" Transite pipe @ .90		31 50		\$472.92
	3 6" Couplings 1.78		5 34		
	1 90o El		5 65		
	1 6" Plug		2 38		
	2 Dozen brick .07 ea		1 68		
	2 Ton cold patch 8.00		16 00		OUTSIDE NO CHG.
	3 Lds. Gravel 14.00		42 00	5/19/72	Labor 20 98
	3 Ton Hot top 7.45		22 35		4' 16" Concrete Pipe 1.80 7 20
	6 Hrs. Trucking 3.00		18 00		1 Bag cement 1 95
	1 1/2 Hrs. Trucking 1.50		2 25		24 Bricks .07 ea. 1 68
	1 Hr. Compressor		5 00		<u>31 81</u>
	1 Hr. Loader		4 00		
	4 Hrs. Shovel 6.50		26 00		
	1/2 Hr. Roller 2.00		1 00		
	Trailer		2 00		
			<u>472 92</u>		
6/21/72	38' 6" Transite				
	10' 4" Cast Iron				

DATE \_\_\_\_\_

TOWN OF LEXINGTON — BOARD OF PUBLIC WORKS  
SEWER DIVISION

Sketch of Service Here

**632**

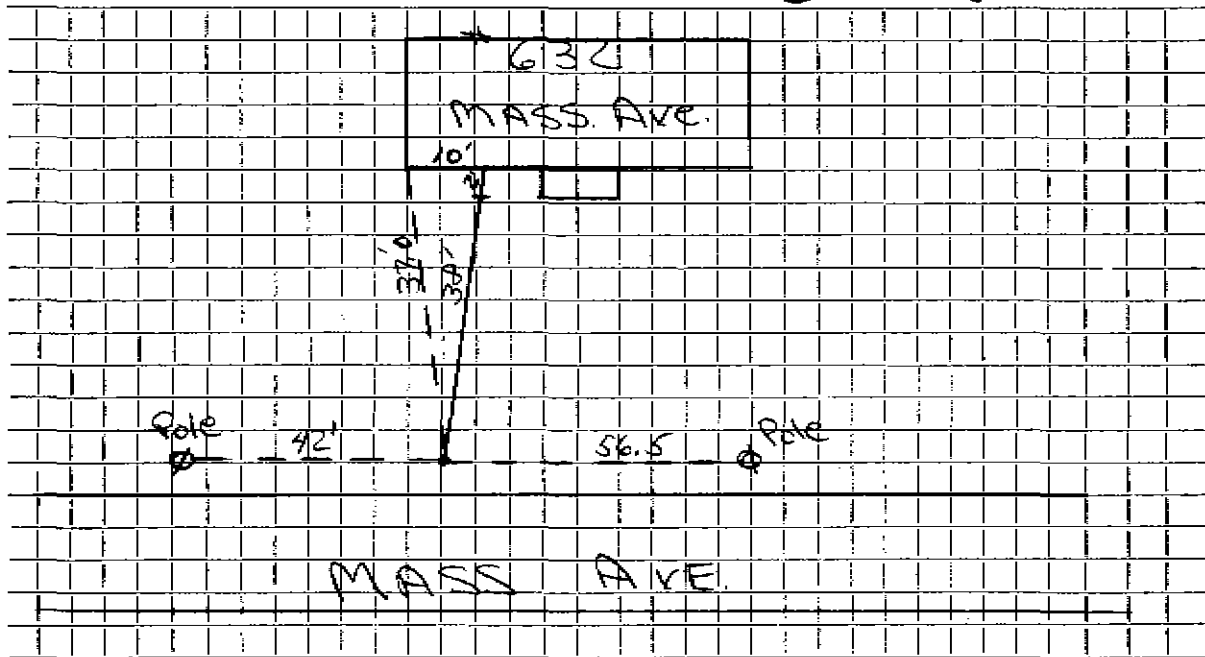

Connection made in ..... Street. Work completed .....

Remarks: .....

.....

.....